

1999 DEC 22 AM 11:25

Patricia A. Morley
REGISTER OF DEEDS

SECTION

LAND CORNER RECORDATION CERTIFICATE
Filing Requirement of Act 74, Mich. P.A. 1970

For corners in MARQUETTE (County) Located In: Corner Code #

1. Public Land Survey T 46N R 25W A-12
T 46N R 26W M-12 ✓
T _____ R _____
T _____ R _____

2. Property Controlling S _____ T _____ R _____
in Section S _____ T _____ R _____

3. Miscellaneous S _____ T _____ R _____
Property in Sec. S _____ T _____ R _____

4. Lot No. _____, Recorded Plat _____

5. Private Claims _____

LIBER **R2** PAGE 204
Register of Deeds Stamp & File Number

I, GERALD W. CARLSON, in a field survey on May 21, 1999, do hereby state that under requirements of P.A. 74, Michigan P.A. of 1970, the corner points mentioned in lines 1 and 2 above were in conformance with regulations and rules therefore as required in the current manual of survey instructions of the United States Department of the Interior, Bureau of Land Management or by a decree of a Court of Law and/or that the corner points mentioned in lines 3, 4 and 5 above were in conformance with the rules of the Michigan Board of Land Surveyors or by a Decree of a Court of Law; established, re-established, monumented, recovered, found as expressed below:

NOTE: Not more than 2 corners, all in the same town and range, may be recorded on this certificate.

A. Description of original monument and accessories and/or subsequent restoration:
A-12: Corner common to Section 31, T46N-R25W and Section 36, T46N-R26W, 1844: William A. Burt's original township boundary survey notes describe the corner monument as a wood post referenced by:

8" Tamarack S39E, 16L 7" Aspen N06W, 35L

(SEE REVERSE SIDE)

B. Description of corner evidence found and/or method applied in restoring or reestablishing corner:

A-12: 1999: No original corner evidence found. Found and accepted a 1 1/4" outside diameter galvanized iron pipe with a 4" aluminum tablet projecting 1.5' above ground.
Checked Line Call: South, enter swamp, course N.N.E. 2 chains (132'), measured 135' with a hip chain.
Checked Line Call: North, stream, 5L (3.3'), course east, 1.75 chains (115.5'), measured 160' to centerline of 4' wide stream with a hip chain. Found:
10" Stump N28E, 16.78' to centerline 10" Stump S76E, 11.71' to centerline
7" Spruce N80W, 11.03' to set d.h. nail (Sackett-1990)
Distance North is 2641.48', South is 2641.96'.

C. Description of monument for corner and accessories established to perpetuate locating the position of the corner:

A-12: 1999: Stamped the 1 1/4" outside diameter galvanized iron pipe with a 4" aluminum tablet monument with "MCR 1999". Reset the monument so it is 1.0' above ground, we could not dig any deeper because of rock.


Measured existing reference:
7" Spruce N80W, 11.03' NBT scribed on butt blaze (Sackett-1990)
Measured new references:
7" Spruce S42W, 29.29' 10" Spruce N18W, 32.23'
9" Spruce N48W, 43.66'

Green Steel Sign Post w/ Yellow Survey Marker Sign N36W, 2.48'

Note: Bearing trees have painted face, butt, and side nail blazes, d.h. measuring nails, and stamped B.T. Tags affixed.
T46N-R25W Corner Search Report 99100

	A	B	C	D	E	F	G	H	I	J	K	L	M
1													
2	6		5		4		3		2		1		
3													
4	7		8		9		10		11		12		
5													
6	18		17		16		15		14		13		
7													
8	19		20		21		22		23		24		
9													
10	30		29		28		27		26		25		
11													
12	31		32		33		34		35		36		
13													

RATIFIED BY DEEDS GROUP
P.A. 345 OF 1990
Larry J. Bussone
DATE 10/25/99

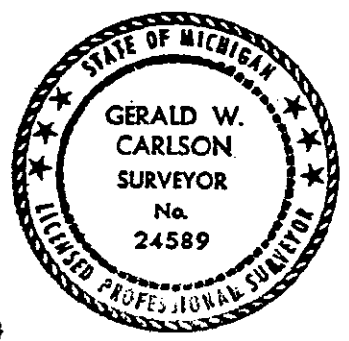

Signed by Gerald W. Carlson Date 12-8-99

A-12:

PART A CONTINUED:

1990: Survey notes by Sundberg, Carlson and Associates, Inc., indicates a corner. No description of monument or accessories.

1990: An LCRC recorded by Keith Sackett, P.S.#19006, Liber 5 RC, Pg. 281, indicates he set a 1" inside diameter iron pipe with 4" aluminum cap midway and on line. Original monument and accessories not found. He established the following references:

7"	Spruce	S72E,	11.7'	1/4 S	NBT
6"	Spruce	N72W,	10.6'	1/4 S	NBT
8"	Jack Pine	N30E,	16.2'	1/4 S	NET
7"	Spruce squared	S55W,	2.5'		

1990: A survey calculation sheet by Gerry Carlson, P.S.#24589, does not indicate a corner at this location. The calculations show a distance of N01-14-04E, 10,567.12' from the Southwest corner of Section 31, to the Northwest corner of Section 30.

1990: A survey reference map by Sundberg, Carlson and Associates, Inc., indicates a corner. No description or references given.

SECTION

SECTION