

MICHIGAN  
DEPARTMENT OF CONSERVATION  
FORESTRY DIVISION

# LAND CORNER RECORD

T. 46 N.R. 27W


Marquette COUNTY

DESCRIPTION OF CORNER 1/4 Corner between Sections 21-28

CORNER MONUMENT 1" Pipe with 4" Aluminum Cap.

DATE MONUMENT PLACED AND WITNESSED 6/15/67

WITNESSES TO CORNER..... 8" Jack Pine (1/4S NBT) S2°W 24.3'

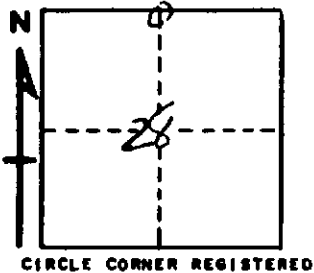

9" Jack Pine (1/4S NBT) N30°E 18.2'

AND

**DESCRIPTION IN DETAIL AS TO HOW CORNER WAS LOCATED AND IDENTIFIED OR RESTORED.**

This corner re-established midway and on line  
between two Section Corners.  
Found no evidence of Original Corner.

**SURVEYOR'S SEAL**

SIGNED Billy D. Buckler  
Billy D. Buckler  
REGISTERED LAND SURVEYOR

DATE 10/25/67