

MICHIGAN
DEPARTMENT OF CONSERVATION
FORESTRY DIVISION

LAND CORNER RECORD

T. 46 N.R. 27W


Marquette COUNTY

DESCRIPTION OF CORNER North 1/16 Corner between Sections 28-29

CORNER MONUMENT 1" Pipe with 4" Aluminum Cap.

DATE MONUMENT PLACED AND WITNESSED 6/15/67

WITNESSES TO CORNER..... 7" Jack Pine (1/16 BT) East 29.5'

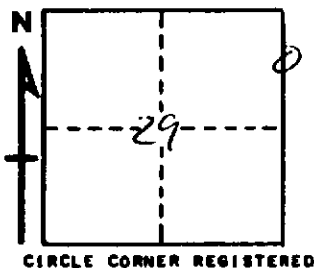

8" Jack Pine (1/16 BT) N80°W 21.9'

AND

DESCRIPTION IN DETAIL AS TO HOW CORNER WAS LOCATED AND IDENTIFIED OR RESTORED.

Corner lies on East edge trail road.

SURVEYOR'S SEAL

Billy D. Duckler
SIGNED Billy D. Duckler DATE 10/25/67
REGISTERED LAND SURVEYOR