

MICHIGAN  
DEPARTMENT OF CONSERVATION  
FORESTRY DIVISION

LAND CORNER RECORD

T. 46 N.R. 27W


Marquette COUNTY

DESCRIPTION OF CORNER 1/4 Corner between Sections 21-22

CORNER MONUMENT \_\_\_\_\_

DATE MONUMENT PLACED AND WITNESSED 5/31/67

WITNESSES TO CORNER..... 11" Jack Pine (1/4S NBT) S28°W 9.3'

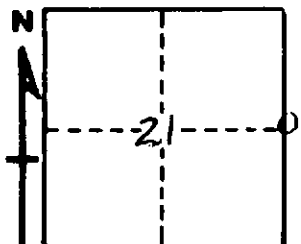

10" Jack Pine " S57°E 10.5'

AND

CIRCLE CORNER REGISTERED

DESCRIPTION IN DETAIL AS TO HOW CORNER WAS LOCATED AND IDENTIFIED OR RESTORED.

This corner re-established midway and on line between two Section Corners. Found no evidence of Original Corner.

Corner lies 5 chains South of the Voelker Lake Road.

SURVEYOR'S SEAL

SIGNED Billy D. Buckler  
Billy D. Buckler  
REGISTERED LAND SURVEYOR

DATE 10/25/67