

JOB NUMBER: 94030
SHEET NO. : 1-486

LAND CORNER RECORDATION CERTIFICATE
Filing Requirement of Act 74, Mich. P.A. 1970

MARQUETTE COUNTY
MICHIGAN
RECEIVED FOR RECORD

1994 DEC 28 PM 5:56

For corners in
MARQUETTE
(County)

Located In: Corner Code #

1. Public Land Survey	T	47N	R	27W	B-13
	T	46N	R	27W	B-1
	T		R		
	T		R		
2. Property Controlling in Section	S		T	R	
	S		T	R	
3. Miscellaneous Property in Sec.	S		T	R	
	S		T	R	

Patricia A. Mosley
REGISTER OF DEEDS

LIBER 1 PAGE 157

Register of Deeds Stamp & File Number

4. Lot No. _____, Recorded Plat _____
5. Private Claims _____

I, GERALD W. CARLSON, in a field survey on Tuesday, December 27, 1994, do hereby certify that under requirements of P.A. 74, Michigan P.A. of 1970, the corner points mentioned in lines 1 and 2 above were in conformance with regulations and rules therefore as required in the current manual of survey instructions of the United States Department of the Interior, Bureau of Land Management or by a decree of a Court of Law and/or that the corner points mentioned in lines 3, 4 and 5 above were in conformance with the rules of the Michigan Board of Land Surveyors or by a Decree of a Court of Law; established, re-established, monumented, re-monumented, recovered, found as expressed below:

A	B	C	D	E	F	G	H	I	J	K	L	M
2	6	5	4	3	2	1						
3												
4	7	8	9	10	11	12						
5												
6	18	17	16	15	14	13						
7												
8	19	20	21	22	23	24						
9												
10	30	29	28	27	26	25						
11												
12	31	32	33	34	35	36						
13												

NOTE: Not more than 4 corners, all in the same town and range, may be recorded on this certificate.

A. Description of original monument and accessories and/or subsequent restoration:

B-13: 1/4 Corner common to Section 6, T46N-R27W and distances from A1 and C1 on line. Set a 1/2" x 24" cap rebar
Section 31, T47N-R27W. witnessed by PK nails in:

1846: Austin Burt's original survey notes describe the 8" Spruce, S20W, 4.16'
Corner monument as a Cherry post referenced by: 10" Jack Pine, West 19.07'
8" White Pine, N15E, 34.1 8" Jack Pine, N20E, 6.21'
10" Spruce.Pine, N69 1/2W, 30.1 8" Jack Pine, N85E, 26.28'
1980: A Land Corner Recordation Certificate filed by Liber 4RC, Page 15.
Charles F. Clark, RLS #25836 indicates no visible evidence
of Corner or accessories-established at proportionate

B. Description of corner evidence found and/or method applied in restoring or reestablishing corner:

1994: Found and accepted 1/2" rebar as referenced in Part "A" above. Distance West is 2744.38' and distance East is 2656.21'.


RATIFIED BY PEER GROUP
P.A. 845 OF 1990

Larry J. Busome
DATE Nov 21, 1994

C. Description of monument for corner and accessories established to perpetuate locating the position of the corner:

1994 - Replaced 1/2" iron and cap #25836 with a 2 1/2" diameter aluminum pipe capped with a 3 1/4" diameter aluminum tablet Marquette County Survey Monument stamped to identify the corner referenced by nails in:

12" Jack Pine N23E 34.60 ft.
16" White Spruce N49E 44.66 ft.
6" Poplar S60E 26.09 ft.
12" Jack Pine West 18.98 ft. Clark NET
Steel sign post N05W 2.06 ft.
Monument is 0.40' above ground and is +/- 85' South of centerline of a 2 - track road.
Bk. 9, Pg. 14

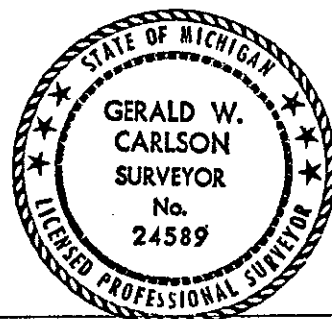

Signed by Gerald W. Carlson Date 12-28-94
Surveyor's Michigan License No. _____