

JOB NUMBER: 94030  
SHEET NO. : 1-488  
For corners in

**LAND CORNER RECORDATION CERTIFICATE**  
Filing Requirement of Act 74, Mich. P.A. 1970

*Patricia A. Mowley*  
REGISTER OF DEEDS

<u>MARQUETTE</u> (County)	Located In:	Corner Code #:
1. Public Land Survey	T <u>47N</u> R <u>27W</u>	D-13
	T <u>46N</u> R <u>27W</u>	<u>D-1</u> ✓
	T _____ R _____	_____
	T _____ R _____	_____
2. Property Controlling in Section	S _____ T _____ R _____	_____
	S _____ T _____ R _____	_____
3. Miscellaneous Property in Sec.	S _____ T _____ R _____	_____
	S _____ T _____ R _____	_____

LIBER **1** PAGE **159**  
Register of Deeds Stamp & File Number

4. Lot No. \_\_\_\_\_, Recorded Plat \_\_\_\_\_  
5. Private Claims \_\_\_\_\_

I, GERALD W. CARLSON, in a field survey on Wednesday, December 21, 1994, do hereby certify that under requirements of P.A. 74, Michigan P.A. of 1970, the corner points mentioned in lines 1 and 2 above were in conformance with regulations and rules therefore as required in the current manual of survey instructions of the United States Department of the Interior, Bureau of Land Management or by a decree of a Court of Law and/or that the corner points mentioned in lines 3, 4 and 5 above were in conformance with the rules of the Michigan Board of Land Surveyors or by a Decree of a Court of Law; established, re-established, monumented, re-monumented, recovered, found as expressed below:

**NOTE: Not more than 4 corners, all in the same town and range, may be recorded on this certificate.**

A	B	C	D	E	F	G	H	I	J	K	L	M
2	6	5	4	3	2	1						
3												
4	7	8	9	10	11	12						
5												
6	18	17	16	15	14	13						
7												
8	19	20	21	22	23	24						
9												
10	30	29	28	27	26	25						
11												
12	31	32	33	34	35	36						
13												

**A. Description of original monument and accessories and/or subsequent restoration:**

D-13: 1/4 Corner common to Section 5, T46N-R27W and Section 32, T47N-R27W.  
1846: Austin Burt's original survey notes describe the corner monument as a Cedar post referenced by:  
10" Maple, N40E, 46 l  
7" Maple, N66W, 53 l

**B. Description of corner evidence found and/or method applied in restoring or reestablishing corner:**


1994: The Corner position established at proportional distance and on line between the SW Corner of Section 32 and the Meander Corner West of Long Lake. Distance West is 2650.65' and distance East is 2091.36' to Meander Corner.

**RATIFIED BY PEER GROUP  
P.A. 345 OF 1990**

*Larry J. Bassone*  
DATE Dec. 6, 1994

**C. Description of monument for corner and accessories established to perpetuate locating the position of the corner:**

1994 - Set a 2 1/2" diameter aluminum pipe capped with a 3 1/4" diameter aluminum tablet Marquette County Survey Monument stamped to identify the corner referenced by nails in:  
4" Spruce S49W 40.19 ft.  
3 1/2" Spruce N05W 22.15 ft.  
3 1/2" Spruce N71E 21.92 ft.  
4" Spruce N87E 4.27 ft.  
Steel sign post N79E 1.26 ft.  
Monument is 0.3' above ground.  
Bk. 5, Pg. 131

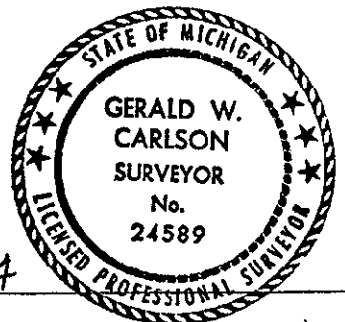

Signed by Gerald W. Carlson  
Surveyor's Michigan License No. 24589

Date 12-22-94