

1994 DEC 28 PM 5:57

JOB NUMBER: 94030
SHEET NO. : 1-492
For corners in

LAND CORNER RECORDATION CERTIFICATE
Filing Requirement of Act 74, Mich. P.A. 1970

Patricia A. Manley
REGISTER OF DEEDS

<u>MARQUETTE</u> (County)	Located In:	Corner Code #
1. Public Land Survey	T <u>47N</u> R <u>27W</u>	F-13
	T <u>46N</u> R <u>27W</u>	<u>F-1</u> ✓
	T _____ R _____	_____
	T _____ R _____	_____
2. Property Controlling in Section	S _____ T _____ R _____	_____
	S _____ T _____ R _____	_____
3. Miscellaneous Property in Sec.	S _____ T _____ R _____	_____
	S _____ T _____ R _____	_____

LIBER 1 PAGE 162
Register of Deeds Stamp & File Number

4. Lot No. _____, Recorded Plat _____
5. Private Claims _____

I, GERALD W. CARLSON, in a field survey on Wednesday, December 21, 1994, do hereby certify that under requirements of P.A. 74, Michigan P.A. of 1970, the corner points mentioned in lines 1 and 2 above were in conformance with regulations and rules therefore as required in the current manual of survey instructions of the United States Department of the Interior, Bureau of Land Management or by a decree of a Court of Law and/or that the corner points mentioned in lines 3, 4 and 5 above were in conformance with the rules of the Michigan Board of Land Surveyors or by a Decree of a Court of Law; established, re-established, monumented, re-monumented, recovered, found as expressed below:

A	B	C	D	E	F	G	H	I	J	K	L	M
2	6	5	4	3	2	1						
3												
4	7	8	9	10	11	12						
5												
6	18	17	16	15	14	13						
7												
8	19	20	21	22	23	24						
9												
10	30	29	28	27	26	25						
11												
12	31	32	33	34	35	36						
13												

NOTE: Not more than 4 corners, all in the same town and range, may be recorded on this certificate.

A. Description of original monument and accessories and/or subsequent restoration:

F-13: 1/4 Corner common to Sections 4, T46N-R27W and Section 33, T47N-R27W,	10" White Pine N27E 19 1
1846: Austin Burt's original survey notes describe the corner monument as a Sugar post referenced by:	17" White Pine South 07 1/2 L
10" Sugar N52 1/2E 11 1	80 paces South to Good Rut Road. Line marked on 6" Poplar north of road. The old stake was shown to me by R.E. Magnuson of the CCI Company Mine Department. It shows up in the old survey notes as long ago as November 1921.
24" White Pine N41 1/2W 34 1	The Gov't. pine stump for the B.T. is still here, the marking on the notch blaze are weathered off but the facing is plain. A 24" White Pine N41 1/2W 34 1 from the pipe.
1955: Land Corner Record filed by R.J. Brotherton indicates he set a new 1" iron pipe 2' long in place of old squared and down cedar post referenced by:	

B. Description of corner evidence found and/or method applied in restoring or reestablishing corner:


1994: Found and accepted 1" iron pipe as referenced in Part "A" above. Distance West is 3384.89' and distance East is 2609.45'.

RATIFIED BY PEER GROUP
P.A. 345 OF 1990

Larry J. Bussine
DATE Nov 21, 1994

C. Description of monument for corner and accessories established to perpetuate locating the position of the corner:

1994 - Replaced 1" iron pipe with a 2 1/2" diameter aluminum pipe capped with a 3 1/4" diameter aluminum tablet Marquette County Survey Monument stamped to identify the corner referenced by nails in:
19" White Pine Due South 5.26 ft. Brotherton NBT
13" Spruce S63W 25.59 ft.
15" White Pine N32E 13.20 ft. Brotherton NBT
4 1/2" Balsam S76E 18.79 ft.
Steel sign post N06W 1.18 ft.
Monument is 0.5' above ground.
Bk. 5, Pg. 133

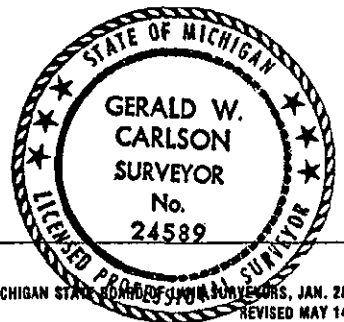

Signed by Gerald W. Carlson Date 12-22-94

Surveyor's Michigan License No. 24589