

1994 DEC 28 PM 5:57

*Patricia H. Monley*  
REGISTER OF DEEDS

LAND CORNER RECORDATION CERTIFICATE  
Filing Requirement of Act 74, Mich. P.A. 1970

BOOK NUMBER: 94030  
DEED NO.: 1-494  
corners in

MARQUETTE (County)	Located In:	Corner Code #
Public Land Survey	T <u>47N</u> R <u>27W</u>	H-13: <u>H-1</u> ✓
	T <u>46N</u> R <u>27W</u>	
	T _____ R _____	
	T _____ R _____	
Property Controlling in Section	S _____ T _____ R _____	
Miscellaneous	S _____ T _____ R _____	
Property in Sec.	S _____ T _____ R _____	

LIBER 1 PAGE 164  
Register of Deeds Stamp & File Number

Lot No. \_\_\_\_\_, Recorded Plat \_\_\_\_\_  
Private Claims \_\_\_\_\_

GERALD W. CARLSON, in a field survey on Monday, December 19, 1994,  
thereby certify that under requirements of P.A. 74, Michigan P.A. of 1970, the corner points mentioned  
in lines 1 and 2 above were in conformance with regulations and rules therefore as required in the  
current manual of survey instructions of the United States Department of the Interior, Bureau of Land  
Management or by a decree of a Court of Law and/or that the corner points mentioned in lines 3, 4 and 5  
above were in conformance with the rules of the Michigan Board of Land Surveyors or by a Decree of a  
Court of Law; established, re-established, monumented, re-monumented, recovered, found as  
described below:

A	B	C	D	E	F	G	H	I	J	K	L	M
2	6	5	4	3	2	1						
3												
4	7	8	9	10	11	12						
5												
6	13	17	16	15	14	13						
7												
8	19	20	21	22	23	24						
9												
10	30	29	28	27	26	25						
11												
12	31	32	33	34	35	36						
13												

**NOTE: Not more than 4 corners, all in the same town and range, may be recorded on this certificate.**

Description of original monument and accessories and/or subsequent restoration:

H-13: 1/4 Corner common to Section 3, T46N-R27W and Section 34, T47N-R27W.  
1846: Austin Burt's original survey notes describe the corner monument as a Maple post referenced by:  
8" Fir N33 1/2E 18 1  
8" Sugar N39W 10 1  
1921: Old field notes of Section 34, T47N-R27W from CCI Company indicates a South 1/4 corner of Section 34 as a square Pine. No corner accessories given.

1933: MCRC field book No. 587 indicates a North 1/4 corner of Section 3, T46N-R27W as a squared White Pine. Found no evidence of original B.T.'s. Sugar and Fir B.T.'s have disappeared. However, the US field notes locate the squared White Pine very closely if not exactly to the original location. On West side of granite ledge showing slight indications of iron ore. (See reverse side).


Description of corner evidence found and/or method applied in restoring or reestablishing corner:

1994: Found and accepted 1/2" rod as referenced in Part "A" above. Distance West is 2616.65' and distance East is 2613.76'.

RATIFIED BY PEER GROUP  
P.A. 345 OF 1990  
*Larry J. Bussard*  
DATE Dec 6, 1994

Description of monument for corner and accessories established to perpetuate locating the position of the corner:

1994 - Replaced 1/2" iron and cap #25839/30091 with a 2 1/2" diameter aluminum pipe capped with a 3 1/4" diameter aluminum tablet Marquette County Survey Monument stamped to identify the corner referenced by nails in:  
2" White Pine S30E 17.53 ft. Clark NBT  
2" White Pine S03W 6.18 ft. Clark NBT  
2" White Pine S29W 19.12 ft. Clark NBT  
7" Twin Oak N55W 18.72 ft. Clark NBT  
Steel sign post East 1.0 ft.  
Monument is 0.40' above ground.  
-c. 8, Pg. 51

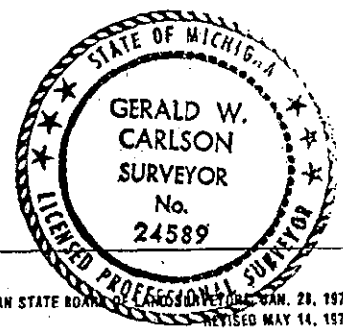

by Gerald W. Carlson Date 12-22-94  
Surveyor's Michigan License No. 24589

Record No. 494

1986: A Certificate of Survey filed by James Minard RLS No. 30091 recorded in L, 358 pg. 631 indicates a North 1/4 corner of Section 3 T46N-R27W as a set capped re-bar. No corner accessories given.

1986: Land Corner Recordation Certificate filed by Charles F. Clark RLS No. 25836 found no evidence of prior corner monumentation - established on straight line between G-1 and I-1 2616.62' East of G-1 and 2613.67' West of I-1. Referenced by PK nails in:

24" Twin Oak	N45W	18.65
15" White Pine	S10W	6.21
14" White Pine	S19E	17.63
15" White Pine	S39W	19.13

Liber, 5RC, pg. 88

*RLS 644  
Geo  
Leo Ram*