

SURVEY & REMONUMENTATION

MARQUETTE COUNTY
MICHIGAN
RECEIVED FOR RECORD

JOB NUMBER: 94030
SHEET NO.: 1-499

APR 28 1995

LAND CORNER RECORDATION CERTIFICATE
Filing Requirement of Act 74, Mich. P.A. 1970

1994 DEC 28 PM 5:57

For corners in


COMMISSION

Patricia A. Moulton
REGISTER OF DEEDS

MARQUETTE (County)	Located In:	Corner Code #
1. Public Land Survey	T 47N R 27W	M-13
	T 47N R 26W	A-13
	T 46N R 26W	A-1
	T 46N R 27W	M-1 ✓
2. Property Controlling in Section	S _____ T _____ R _____	_____
3. Miscellaneous Property in Sec.	S _____ T _____ R _____	_____

LIBER **1** PAGE **169**
Register of Deeds Stamp & File Number

4. Lot No. _____, Recorded Plat _____
5. Private Claims _____

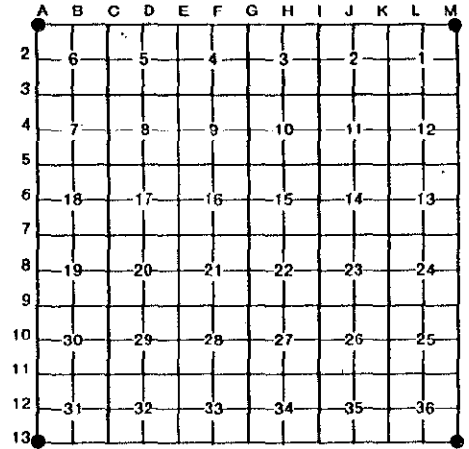

I, GERALD W. CARLSON, in a field survey on Friday, December 16, 1994, do hereby certify that under requirements of P.A. 74, Michigan P.A. of 1970, the corner points mentioned in lines 1 and 2 above were in conformance with regulations and rules therefore as required in the current manual of survey instructions of the United States Department of the Interior, Bureau of Land Management or by a decree of a Court of Law and/or that the corner points mentioned in lines 3, 4 and 5 above were in conformance with the rules of the Michigan Board of Land Surveyors or by a Decree of a Court of Law; established, re-established, monumented, re-monumented, recovered, found as expressed below:

NOTE: Not more than 4 corners, all in the same town and range, may be recorded on this certificate.

A. Description of original monument and accessories and/or subsequent restoration:

<p>M-13: Section Corner common to Section 36, T47N-R27W . . . 1846: Austin Burt's original town line survey of the South Section 31, T47N-R26W, Section 6, T46N-R26W, Section 1, T46N-R27W.</p> <p>1844: William A. Burt's original survey notes indicated he intersected at temporary T.COR. and established Corner of Twp. 46 & 47 North. Between Rs. 26 & 27 West referenced by:</p> <p>18" White Pine S21W 17 l 10" Black Oak N20E 16 l</p>	<p>1846: Austin Burt's original town line survey of the South boundary of T47N-R27W indicate a post for the Corner of T46N & T47N - R26W & R27W with the same identical bearing trees established by William A. Burt in 1844.</p> <p>1932: M.C.R.C. field book no. 545 indicates the NW Corner of Section 6, T46N-R27W as a fence post at fence intersection. Cannot be proven by US field notes. Very little topography given but appears to be about right. A few Black Oak on this hillside and none in the near vicinity. (See reverse side).</p>
---	---

B. Description of corner evidence found and/or method applied in restoring or reestablishing corner:

1994: Found and accepted 1/2" re-rod as referenced in part "A" above. Distance West is 2637.37' and distance North is 2596.12'.

DATTED BY PEER GROUP
P.A. 345 OF 1990

Larry J. Susanne
DATE Dec 16, 1994

C. Description of monument for corner and accessories established to perpetuate locating the position of the corner:

1994 - Replaced 1/2" iron and cap #15415 with a 2 1/2" diameter aluminum pipe capped with a 3 1/4" diameter aluminum tablet Marquette County Survey Monument stamped to identify the corner referenced by nails in:

Power pole	S43W	44.79 ft.	Clark NBT
Power pole	S15E	33.20 ft.	Clark NBT
Rock face	N15E	18.84 ft.	Clark Accessory (spike in rock)
7" Oak	S44E	112.63 ft.	
5" Oak	S52E	106.18 ft.	

Steel sign post Northeast 1.0 ft.
Monument is 0.40' above ground and in power line. Bk. 5, Pg. 41



Signed by Gerald W. Carlson Date 12-22-94
Surveyor's Michigan License No. 24589