

MICHIGAN
DEPARTMENT OF CONSERVATION
FORESTRY DIVISION

LAND CORNER RECORD

T. 46. NR. 28. W


Marquette COUNTY

DESCRIPTION OF CORNER East 1/8 Corner for Section 2

DESCRIPTION OF CORNER MONUMENT 1" x 48" Iron Pipe

WITNESSES TO CORNER 9" Jack Pine (BT) N 50° E 45 Links

8" Jack Pine (BT) N 39° W 31 1/2 Links

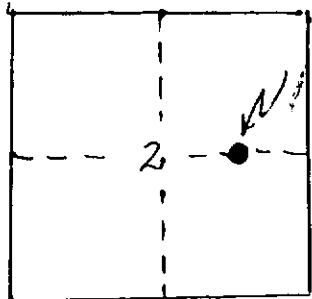

DESCRIPTION IN DETAIL AS TO HOW CORNER WAS LOCATED AND IDENTIFIED OR RESTORED.

This corner was established midway and on line between center of section and the east quarter corner.

Corner was placed and witnessed April 18, 1960 with Frank J. Bray.

SURVEYORS SEAL

SIGNED Billy D. Buckler DATE 5/23/60
REGISTERED LAND SURVEYOR
Billy D. Buckler