

✓

MICHIGAN  
DEPARTMENT OF CONSERVATION  
FORESTRY DIVISION

LAND CORNER RECORD

T. 46. NR. 28 . . .


. . . M a r q u e t t e . . . . . COUNTY

DESCRIPTION OF CORNER North 1/8 corner between Sections 3 and 4 . . . . .

DESCRIPTION OF CORNER MONUMENT 1" x 48" Iron Pipe . . . . .

WITNESSES TO CORNER 7" Aspen (BT) S 44° W 26 Links . . . . .

7" Aspen (BT) S 58° E 15 Links . . . . .

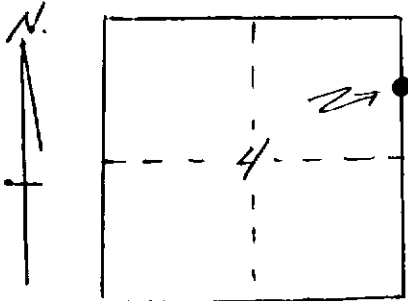

DESCRIPTION IN DETAIL AS TO HOW CORNER WAS LOCATED AND IDENTIFIED OR RESTORED.

This corner was established by single proportionate measure between Section corner to North and 1/4 corner to south. Squared and scribed 8" Aspen at corner.

Corner was placed and witnessed May 17, 1960 with Frank J. Bray.

SURVEYORS SEAL

SIGNED Billy D. Buckler DATE 5/23/60  
REGISTERED LAND SURVEYOR  
Billy D. Buckler