

MICHIGAN
DEPARTMENT OF CONSERVATION
FORESTRY DIVISION

LAND CORNER RECORD

T. 46N N.R. 28W


Marquette COUNTY

DESCRIPTION OF CORNER 1/4 corner bet. secs. 9-10

CORNER MONUMENT 1" pipe with 4" aluminum cap.

DATE MONUMENT PLACED AND WITNESSED 5/5/67

WITNESSES TO CORNER..... 22" Red pine (1/4 S NBT) S42°W 17.5'

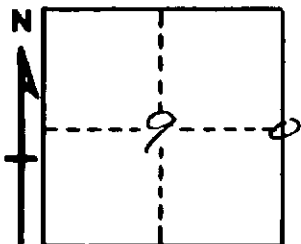

18" Red Pine (1/4 S NBT) N35°W 53.4'

AND

CIRCLE CORNER REGISTERED

DESCRIPTION IN DETAIL AS TO HOW CORNER WAS LOCATED AND IDENTIFIED OR RESTORED.

This corner re-established midway and on line between two sec. cors.
Found no evidence of original corner or witnesses.

Swamp edge 2.00 chs. south checks with original notes.

SURVEYOR'S SEAL

Billy D. Buckler
SIGNED Billy D. Buckler DATE May 26, 1967
REGISTERED LAND SURVEYOR