LAND CORNER RECORDATION CERTIFICATE

Filing Requirement of Act 74, Mich. P.A. 1970

For corners in

T Marquette
(County)

			Located In:		Corner Code #1	
1	Public Land Survey		T 46N	R28W		
			T	R		
			T	R		
			T	R		
2	Property Controlling	S28	T	R	9	
	in Section	S	T	R	16	
3	Miscellaneous	S	T	R		
	Property in Sec	S	T	R		

Register of Deeds Stamp & File Number

4 Lot No. , Recorded Plat

5 Private Claims

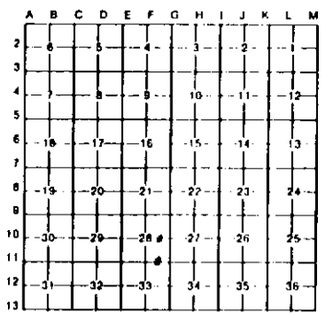

I, Keith Sackett, in a field survey on March 1, 19 90, do hereby certify that under requirements of P.A. 74, Michigan P.A. of 1970, the corner points mentioned in lines 1 and 2 above were in conformance with regulations and rules therefore as required in the current manual of survey instructions of the United States Department of the Interior, Bureau of Land Management or by a decree of a Court of Law and/or that the corner points mentioned in lines 3, 4 and 5 above were in conformance with the rules of the Michigan Board of Land Surveyors or by a Decree of a Court of Law, established, re-established, monumented, re-monumented, recovered, found as expressed below.

NOTE: Not more than 4 corners, all in the same town and range, may be recorded on this certificate.

A. Description of original monument and accessories and/or subsequent restoration:

9	16
Not set on original survey nor subsequently, apparently.	Not set on original survey nor subsequently, apparently.

B. Description of corner evidence found and/or method applied in restoring or reestablishing corner.

9	16
Established midway and on line between corners east and west.	Established midway and on line between corners east and west.

C. Description of monument for corner and accessories established to perpetuate locating the position of the corner:

9	16
Set 1" ID x 32" iron pipe w/4" aluminum cap. 6" j. pine N83E 36.4' 1/16s, BT 5" j. pine S40E 40.4' 1/16s, BT 12" j. pine N72W 29.2' 1/16s, BT	Set 1" ID x 32" iron pipe w/4" aluminum cap. 8" j. pine squared north 1.0' 6" spruce S80W 16.4' 1/16s, BT 5" spruce S10E 3.9' 1/16s, BT 4" spruce N88E 9.4' 1/16s, BT

Signed by Keith Sackett Date August 27, 1990

Surveyor's Michigan License No 19006

FORM APPROVED BY MICHIGAN STATE BOARD OF LAND SURVEYORS, JAN. 28, 1971
REVISED MAY 14, 1975
REVISED JAN., 1983