

LAND CORNER RECORDATION CERTIFICATE
Filing Requirement of Act 74, Mich. P.A. 1970

For corners in Marquette (County) Located In: Corner Code #
1. Public Land Survey T R
2. Property Controlling in Section S 35 T 46N R 28W 12
3. Miscellaneous Property in Sec. S T R

Register of Deeds Stamp & File Number

4. Lot No. Recorded Plat
5. Private Claims

15 May 29 1997
12 Mar 05 1997

I, Paul R. Bressette, in a field survey on 19 do hereby state that under requirements of P.A. 74, Michigan P.A. of 1970, the corner points mentioned in lines 1 and 2 above were in conformance with regulations and rules therefore as required in the current manual of survey instructions of the United States Department of the Interior, Bureau of Land Management or by a decree of a Court of Law and /or that the corner points mentioned in lines 3, 4 and 5 above were in conformance with the rules of the Michigan Board of Land Surveyors or by a Decree of a Court of Law, established, re-established, monumented, recovered, found as expressed below:

NOTE: Not more than 2 corners, all in the same town and range, may be recorded on this certificate.

Grid table with columns A-N and rows 1-13. Contains numbers 1-36 and a small dot in row 12, column J.

A. Description of original monument and accessories and/or subsequent restoration:


- (12) South One-sixteenth corner of Section 35. Not set in original survey, no evidence of subsequent establishment.
(15) West One-sixteenth corner common to Sections 35 and 2. Found 2 pipes side by side about 5 feet south of monumented position, not of record.

B. Description of corner evidence found and/or method applied in restoring or reestablishing corner:

- (12) Corner position established mid-point and on-line between the Center and South Quarter corners of Section 35.
(15) Rejected side by side pipes due to distance off line. Corner position established mid-point and on-line between the southwest and south quarter corners of Section 35. Corner falls in dirt road about 2 feet south of centerline, set 6 inches below grade.

C. Description of monument for corner and accessories established to perpetuate locating the position of the corner:

- (12) DNR monument: 12" W.Pine N74E 37.9' (1/16S,NBT), 11" W.Pine S49E 32.25' (1/16S,NBT), 11" J.Pine S54W 35.9' (1/16S,NBT), 10" J.Pine N02E 51.45' (1/16S,NBT). All trees are blazed, scribed and painted. Measurements are to notch in butt blaze, bearings are magnetic.
(15) DNR monument: 5" J.Pine N15E 17.55' (1/16S,BT), 6" J.Pine N69E 34.4' (1/16S,BT), 5" R.Pine S70E 25.95' (1/16S,BT), 7" R.Maple S82W 50.8' (1/16S,BT). All trees are blazed, scribed and painted. Measurements are nail in side of tree, bearings are magnetic. Wood post with location poster 15 feet north.

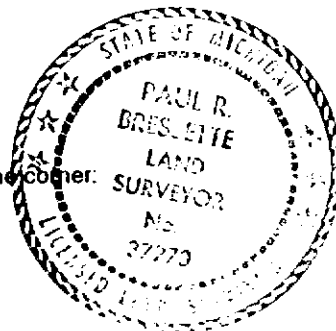

Signed by Paul R. Bressette Date
Surveyor's Michigan License No. 37270

For the Michigan Department of Natural Resources - Forest Management Division