

LAND CORNER RECORDATION CERTIFICATE  
Filing Requirement of Act 74, Mich. P.A. 1970

For corners in  
Marquette  
(County)

Located In: Corner Code #

1. Public Land Survey  
T\_\_\_ R\_\_\_  
T\_\_\_ R\_\_\_  
T\_\_\_ R\_\_\_  
T\_\_\_ R\_\_\_

2. Property Controlling in Section  
S 35 T 46N R 28W 8  
S 35 T 46N R 28W 11

3. Miscellaneous Property in Sec.  
S\_\_\_ T\_\_\_ R\_\_\_  
S\_\_\_ T\_\_\_ R\_\_\_

Register of Deeds Stamp & File Number

4. Lot No. \_\_\_\_\_, Recorded Plat \_\_\_\_\_  
5. Private Claims \_\_\_\_\_

11 Mar 06 1997  
8 Mar 10 1997

I, Paul R. Bressette, in a field survey on \_\_\_\_\_, 19\_\_\_\_ do hereby state that under requirements of P.A. 74, Michigan P.A. of 1970, the corner points mentioned in lines 1 and 2 above were in conformance with regulations and rules therefore as required in the current manual of survey instructions of the United States Department of the Interior, Bureau of Land Management or by a decree of a Court of Law and /or that the corner points mentioned in lines 3, 4 and 5 above were in conformance with the rules of the Michigan Board of Land Surveyors or by a Decree of a Court of Law; established, re-established, monumented, recovered, found as expressed below:

NOTE: Not more than 2 corners, all in the same town and range, may be recorded on this certificate.

	A	B	C	D	E	F	G	H	I	J	K	L	M
1													
2		6		5		4		3		2		1	
3													
4		7		8		9		10		11		12	
5													
6		10		17		16		15		14		13	
7													
8		19		20		21		22		23		24	
9													
10		30		29		28		27		26		25	
11													
12		31		32		33		34		35		36	
13													

A. Description of original monument and accessories and/or subsequent restoration:


- (8) West One-sixteenth corner of Section 35. Not set in original survey, no evidence of subsequent establishment.
- (11) Southwest One-sixteenth corner of Section 35. Found 2" iron pipe 8 feet high set by unknown person, not of record.

B. Description of corner evidence found and/or method applied in restoring or reestablishing corner:

- (8) Corner position established mid-point and on-line between the Center and West Quarter corners of Section 35.
- (11) Rejected iron pipe due to excessive distance from calculated position. Pipe falls 103 feet east of proper position. Corner position established at the intersection of the South and West One-sixteenth lines of Section 35.

C. Description of monument for corner and accessories established to perpetuate locating the position of the corner:

- |   |  |
|---|--|
| (8) DNR monument  | (11) DNR monument  |
| 7" J.Pine N89E 7.55' (1/16S,NBT)  | 6" J.Pine N59E 49.35' (1/16S,NBT)  |
| 1" J.Pine S27E 20.55' (1/16S,NBT)   | 9" W.Pine S15E 16.55' (1/16S,NBT)  |
| 6" J.Pine S47W 12.1' (1/16S,NBT)  | 5" J.Pine S36W 17.2' (1/16S,NBT)   |
| 6" J.Pine N15W 8.85' (1/16S,NBT)  | 8" W.Pine N17W 74.0' (1/16S,NBT)   |
| 11 trees are blazed, scribed and painted. Measurements are to notch in butt blaze, bearings are magnetic. | All trees are blazed, scribed and painted. Measurements are to notch in butt blaze, bearings are magnetic. |

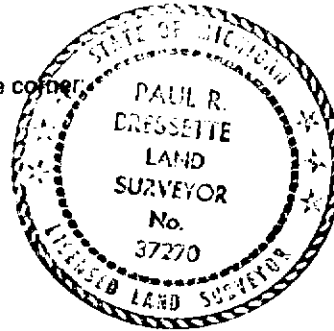

Signed by Paul R. Bressette Date \_\_\_\_\_  
Surveyor's Michigan License No. 37270

For the Michigan Department of Natural Resources - Forest Management Division