

LAND CORNER RECORDATION CERTIFICATE
Filing Requirement of Act 74, Mich. P.A. 1970

For corners in Marquette (County) Located In: Corner Code #
1. Public Land Survey T46N R 28W J12
T46N R 28W J13
2. Property Controlling in Section S T R
3. Miscellaneous Property in Sec. S T R

Register of Deeds Stamp & File Number

4. Lot No. Recorded Plat
5. Private Claims
J13 May 29 1997
J12 Mar 05 1997

Grid table with columns A-M and rows 1-13. Contains numbers 1-36 and a star symbol at row 12, column J.


I, Paul R. Bressette, in a field survey on 19 do hereby state that under requirements of P.A. 74, Michigan P.A. of 1970, the corner points mentioned in lines 1 and 2 above were in conformance with regulations and rules therefore as required in the current manual of survey instructions of the United States Department of the Interior, Bureau of Land Management or by a decree of a Court of Law and/or that the corner points mentioned in lines 3, 4 and 5 above were in conformance with the rules of the Michigan Board of Land Surveyors or by a Decree of a Court of Law; established, re-established, monumented, recovered, found as expressed below:

NOTE: Not more than 2 corners, all in the same town and range, may be recorded on this certificate.

A. Description of original monument and accessories and/or subsequent restoration:
J12) Center Quarter corner of Section 35. Not set in original survey, no evidence of subsequent establishment.
J13) Quarter corner common to Sections 35 and 2. 1846: Austin Burt, DS. Set wood post witnessed by: Y. Pine 12 N 52 1/2 E 31 ks.; Y. Pine 12 N 12 W 18 lks. Found 1" iron pipe, not of record.

B. Description of corner evidence found and/or method applied in restoring or reestablishing corner:
J12) Corner position established at the intersection of the East-West and North-South quarter lines of Section 35.
J13) No evidence of original monument or witnesses found. Found and accepted a one inch iron pipe in approximate centerline of east-west road, very close to a mid-point and on-line position between the section corners. Replaced iron pipe with DNR monument and witnessed.

C. Description of monument for corner and accessories established to perpetuate locating the position of the corner:
J12) DNR monument (J13) DNR monument
2" J.Pine N73E 41.3' (1/4S,NBT) 8" R.Pine N40E 12.5' (1/4S,NBT)
0" J.Pine S38E 10.2' (1/4S,NBT) 6" R.Maple S28E 14.9' (1/4S,NBT)
9" J.Pine S69W 33.85' (1/4S,NBT) 9" W.Pine S58W 21.6' (1/4S,NBT)
5" Spruce N40W 25.9' (1/4S,NBT) 8" R.Pine N29W 27.9' (1/4S,NBT)
All trees are blazed, scribed and painted. Measurements are to notch in butt blaze, bearings are magnetic.
All trees are blazed, scribed and painted. Measurements are to nail in side of tree, bearings are magnetic. Wood post with location poster 8 feet north.

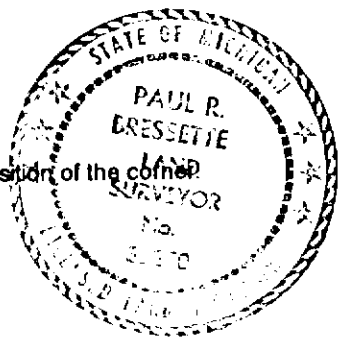

Signed by Paul R. Bressette Date
Surveyor's Michigan License No. 37270

For the Michigan Department of Natural Resources - Forest Management Division