

LAND CORNER RECORDATION CERTIFICATE  
Filing Requirement of Act 74, Mich. P.A. 1970

For corners in

Marquette

(County)

Located In:

Corner Code #

1. Public Land Survey

T \_\_\_ R \_\_\_  
T \_\_\_ R \_\_\_  
T \_\_\_ R \_\_\_  
T \_\_\_ R \_\_\_

2. Property Controlling  
in Section

S 15 T 46N R 28W 1  
S 15 T 46N R 28W 5

3. Miscellaneous  
Property in Sec.

S \_\_\_ T \_\_\_ R \_\_\_  
S \_\_\_ T \_\_\_ R \_\_\_

Register of Deeds Stamp & File Number

4. Lot No. \_\_\_\_\_, Recorded Plat \_\_\_\_\_

5. Private Claims \_\_\_\_\_

5 Oct 30 1997

1 Oct 29 1997

I, Paul R. Bressette, in a field survey on \_\_\_\_\_, 19\_\_ do hereby state that under requirements of P.A. 74, Michigan P.A. of 1970, the corner points mentioned in lines 1 and 2 above were in conformance with regulations and rules therefore as required in the current manual of survey instructions of the United States Department of the Interior, Bureau of Land Management or by a decree of a Court of Law and for that the corner points mentioned in lines 3, 4 and 5 above were in conformance with the rules of the Michigan Board of Land Surveyors or by a Decree of a Court of Law; established, re-established, monumented, recovered, found as expressed below:

NOTE: Not more than 2 corners, all in the same town and range, may be recorded on this certificate.

	A	B	C	D	E	F	G	H	I	J	K	L	M
1													
2	6		5		4			3		2			1
3													
4	7		8		9			10		11			12
5													
6	10		17		16			15		14			13
7													
8	19		20		21			22		23			24
9													
10	30		29		28			27		26			25
11													
12	31		32		33			34		35			36
13													

A. Description of original monument and accessories and/or subsequent restoration:


- 1) West One-sixteenth corner common to Sections 10 and 15. Not set in original survey, no evidence of subsequent establishment.
- 5) North One-sixteenth corner of Section 15. Found 3/4" iron pin.

B. Description of corner evidence found and/or method applied in restoring or reestablishing corner:

- 1) Corner position established mid-point and on-line between the Northwest and North Quarter corners of Section 15. Corner falls on top of hill, west of trail road. Area has been burned, no trees close.
- 5) Accepted found iron pin as corner position. Iron pin is within 0.10 feet of calculated position. Replaced iron pin with DNR monument and witnessed.

C. Description of monument for corner and accessories established to perpetuate locating the position of the corner:

- |                                    |                                   |
|------------------------------------|-----------------------------------|
| 1) DNR monument                    | (5) DNR monument                  |
| " B.Spruce N68E 171.55' (1/16S,BT) | 07" J.Pine N41E 19.7' (1/16S,BT)  |
| " J.Pine S42E 150.40' (1/16S,BT)   | 07" J.Pine S52E 10.95' (1/16S,BT) |
| " B.Pine S08E 171.40' (1/16S,BT)   | 10" J.Pine S45W 9.65' (1/16S,BT)  |
| wood post South 0.5'               | 12" J.Pine N41W 21.75' (1/16S,BT) |
- All trees are blazed, scribed and painted. Measurements are to nail in side of tree, bearings are magnetic.

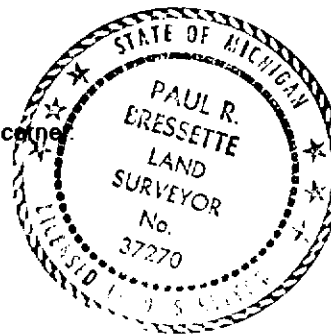

Signed by Paul R. Bressette  
Surveyor's Michigan License No. 37270

Date \_\_\_\_\_

For the Michigan Department of Natural Resources - Forest Management Division