

LAND CORNER RECORDATION CERTIFICATE
Filing Requirement of Act 74, Mich. P.A. 1970

For corners in

Marquette
(County)

Located In:

Corner Code #

1. Public Land Survey

T46N	R 28W	H5
T46N	R 28W	H10
T	R	
T	R	
S	T	R
S	T	R
S	T	R
S	T	R

2. Property Controlling in Section

3. Miscellaneous Property in Sec.

Register of Deeds Stamp & File Number

4. Lot No. _____, Recorded Plat _____

5. Private Claims _____

H10 Oct 09 1997
H5 Oct 27 1997

I, Paul R. Bressette, in a field survey on _____, 19____ do hereby state that under requirements of P.A. 74, Michigan P.A. of 1970, the corner points mentioned in lines 1 and 2 above were in conformance with regulations and rules therefore as required in the current manual of survey instructions of the United States Department of the Interior, Bureau of Land Management or by a decree of a Court of Law and/or that the corner points mentioned in lines 3, 4 and 5 above were in conformance with the rules of the Michigan Board of Land Surveyors or by a Decree of a Court of Law, established, re-established, monumented, recovered, found as expressed below:

NOTE: Not more than 2 corners, all in the same town and range, may be recorded on this certificate.

A	B	C	D	E	F	G	H	I	J	K	L	M
1												
2	6	5	4	3	2	1						
3												
4	7	8	9	10	11	12						
5												
6	18	17	16	15	14	13						
7												
8	19	20	21	22	23	24						
9												
10	30	29	28	27	26	25						
11												
12	31	32	33	34	35	36						
13												

A. Description of original monument and accessories and/or subsequent restoration:

(H5) Quarter corner common to Sections 10 and 15. 1848: Harvey Mellen, D.S. Set wood post witnessed by: W.Pine 24 N79W 12 lks.; W.Pine 20 S63E 52 lks. 1965: MDNR. Traversed south line of Section 10, no evidence of corner mentioned. 1984: Alan K. Pierce, LLS. Certificate of Survey shows calculated position for corner. 1997: MDNR. Found 2" iron pipe not of record.
(H10) Center Quarter corner of Section 27. Not set in original survey, no evidence of subsequent establishment.


B. Description of corner evidence found and/or method applied in restoring or reestablishing corner:

(H5) No evidence of original survey found to substantiate position of found iron pipe. Corner position re-established mid-point and on-line between the Northeast and Northwest corners of Section 15, as shown on Certificate of Survey, and used in subsequent surveys in the Section. Iron pipe is northerly approximately 100 feet from the monumented position.
(H10) Corner position established at the intersection of the North-South and East-West quarter lines of Section 27.

C. Description of monument for corner and accessories established to perpetuate locating the position of the corner:

(H5) DNR monument	(H10) DNR monument
5" J.Pine N10E 30.65' (1/4S,NBT)	08" J.Pine N57E 17.75' (1/4S,BT)
5" Cherry N83E 13.65' (1/4S,NBT)	09" J.Pine S36E 27.65' (1/4S,BT)
8" Cherry S61W 40.1' (1/4S,NBT)	11" J.Pine S40W 14.3' (1/4S,BT)
0" J.Pine N47W 68.0' (1/4S,NBT)	08" J.Pine N28W 10.2' (1/4S,BT)

11 trees are blazed, scribed and painted. Measurements are to nail in side of tree, bearings are magnetic.

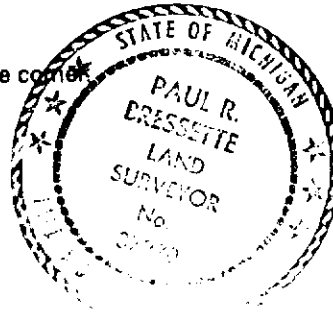

Signed by Paul R. Bressette
Surveyor's Michigan License No. 32270

Date _____

For the Michigan Department of Natural Resources - Forest Management Division