

(46)

LAND CORNER RECORDATION CERTIFICATE
Filing Requirement of Act 74, Mich. P.A. 1970

For corners in

Marquette
(County)

Located In:

Corner Code #

1. Public Land Survey

T___ R___
T___ R___
T___ R___
T___ R___

2. Property Controlling
in Section

S 26 T 46N R 28W 3
S 26 T 46N R 28W 4

3. Miscellaneous
Property in Sec.

S___ T___ R___
S___ T___ R___

Register of Deeds Stamp & File Number

4. Lot No. _____, Recorded Plat _____

5. Private Claims _____

Jul 27 1995

I, Paul R. Bressette, in a field survey on _____, 19____ do hereby state that under requirements of P.A. 74, Michigan P.A. of 1970, the corner points mentioned in lines 1 and 2 above were in conformance with regulations and rules therefore as required in the current manual of survey instructions of the United States Department of the Interior, Bureau of Land Management or by a decree of a Court of Law and for that the corner points mentioned in lines 3, 4 and 5 above were in conformance with the rules of the Michigan Board of Land Surveyors or by a Decree of a Court of Law, established, re-established, monumented, recovered, found as expressed below:

NOTE: Not more than 2 corners, all in the same town and range, may be recorded on this certificate.

	A	B	C	D	E	F	G	H	I	J	K	L	M
1													
2		6		5		4		3		2		1	
3													
4		7		8		9		10		11		12	
5													
6		18		17		16		15		14		13	
7													
8		19		20		21		22		23		24	
9													
10		30		29		28		27		26		25	
11													
12		31		32		33		34		35		36	
13													

A. Description of original monument and accessories and/or subsequent restoration:

- (3) North One-sixteenth corner common to Sections 26 and 27. Not set in original survey, no evidence of subsequent establishment.
- (4) Northwest One-sixteenth corner of Section 26. Not set in original survey, no evidence of subsequent establishment.

B. Description of corner evidence found and/or method applied in restoring or reestablishing corner:

- (3) Corner position established mid-point and on-line between the Northwest and West Quarter corners of Section 26.
- (4) Corner position established at the intersection of the north and west one-sixteenth lines of Section 26.


C. Description of monument for corner and accessories established to perpetuate locating the position of the corner:

- (3) DNR monument
- 15" B. Spruce N11E 12.75'
- 15" Tamarack S77E 11.3'
- 36" B. Spruce S18W 5.2'
- 36" B. Spruce N83W 24.6'

- (4) DNR monument
- 6" J. Pine N86E 7.5'
- 8" J. Pine S15E 20.2'
- 9" J. Pine S47W 20.9'
- 8" J. Pine N21W 26.1'

All trees are blazed, scribed and painted. Measurements are to notch in butt blaze, bearings are magnetic.


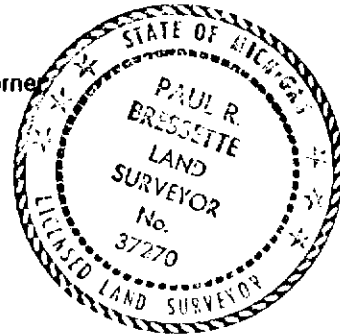

Signed by Paul Bressette
Surveyor's Michigan License No. 37270

Date _____

For the Michigan Department of Natural Resources - Forest Management Division