

LAND CORNER RECORDATION CERTIFICATE
Filing Requirement of Act 74, Mich. P.A. 1970

For corners in

Marquette

(County)

Located In:

Corner Code #

1. Public Land Survey

T___ R___
T___ R___
T___ R___
T___ R___

2. Property Controlling in Section

S 34 T 46N R 28W 1
S 26 T 46N R 28W 1

3. Miscellaneous Property in Sec.

S___ T___ R___
S___ T___ R___

Register of Deeds Stamp & File Number

4. Lot No. _____, Recorded Plat _____

5. Private Claims _____

1 Jul 27 1995 S 26
1 Jun 04 1997 S 34

I, Paul R. Bressette, in a field survey on _____, 19___ do hereby state that under requirements of P.A. 74, Michigan P.A. of 1970, the corner points mentioned in lines 1 and 2 above were in conformance with regulations and rules therefore as required in the current manual of survey instructions of the United States Department of the Interior, Bureau of Land Management or by a decree of a Court of Law and /or that the corner points mentioned in lines 3, 4 and 5 above were in conformance with the rules of the Michigan Board of Land Surveyors or by a Decree of a Court of Law; established, re-established, monumented, recovered, found as expressed below:

NOTE: Not more than 2 corners, all in the same town and range, may be recorded on this certificate.

Grid table with columns A-M and rows 1-13. Contains numbers 1-36 and two black dots at grid intersections.

A. Description of original monument and accessories and/or subsequent restoration:


- (1) West One-sixteenth corner common to Sections 27 and 34. Not set in original survey, no evidence of subsequent establishment.
(1) West One-sixteenth corner common to Sections 23 and 26. Not set in original survey, no evidence of subsequent establishment.

B. Description of corner evidence found and/or method applied in restoring or reestablishing corner:

- (1) Corner position established mid-point and on-line between the Northwest and North Quarter corners of Section 34.
(1) Corner position established mid-point and on-line between the Northwest and North Quarter corners of Section 26.

C. Description of monument for corner and accessories established to perpetuate locating the position of the corner:

- 1) DNR monument S. 34 (1) DNR monument S. 26
8" R. Pine S06E 21.85' 1/16S, BT 05" B. Spruce N52E 18.9'
8" Tamarack S30W 28.4' 1/16S, BT 08" B. Spruce S10E 13.65'
1" J. Pine S61W 33.95' 1/16S, BT 12" J. Pine S28W 13.25'
8" Spruce N52W 4.35' 1/16S, BT 13" J. Pine N56W 25.85'
All trees are blazed, scribed and painted. Measurements are to nail in side of tree, bearings are magnetic.
All trees are blazed, scribed and painted. Measurements are to notch in butt blaze, bearings are magnetic.

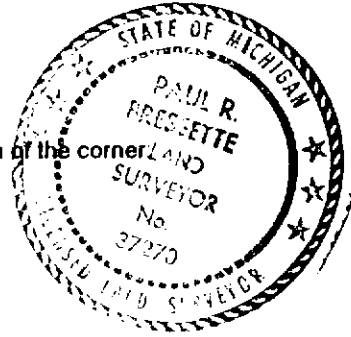

Signed by Paul R. Bressette
Surveyor's Michigan License No. 37270

Date _____

For the Michigan Department of Natural Resources - Forest Management Division