


LAND CORNER RECORDATION CERTIFICATE
Filing Requirement of Act 74, Mich. P.A. 1970

For corners in Marquette Located In: Corner Code #/
1. Public Land Survey T 46N R 28W L11
T 46N R 28W M11
T R
T R
2. Property in Section 25 T 46N R 28W 16
T R
3. Mableylandus Property in Sec T R
T R
4. Lot No. Recorded Plat
5. Private Claims No. 37270

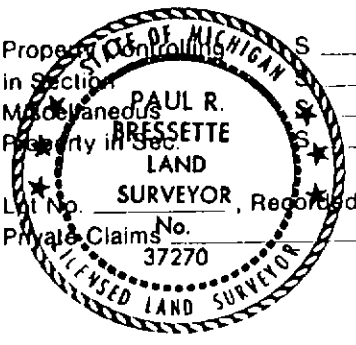

Register of Deeds Stamp & File Number

Grid table with columns A-M and rows 2-13. Contains numbers 1-36 and three dots in row 11, column M.

I, Paul R. Bressette, in a field survey on June 13, 1995, do hereby certify that under requirements of P.A. 74, Michigan P.A. of 1970, the corner points mentioned in lines 1 and 2 above were in conformance with regulations and rules therefore as required in the current manual of survey instructions of the United States Department of the Interior, Bureau of Land Management or by a decree of a Court of Law and/or that the corner points mentioned in lines 3, 4 and 5 above were in conformance with the rules of the Michigan Board of Land Surveyors or by a Decree of a Court of Law; established, re-established, monumented, re-monumented, recovered, found as expressed below:

NOTE: Not more than 4 corners, all in the same town and range, may be recorded on this certificate.

A. Description of original monument and accessories and/or subsequent restoration:

(L11) Quarter corner common to Sections 25 and 36. 1983: David E. Erickson, RLS 29245. Set 5/8 X 36" rebar w/ cap witnessed by: 7" J. Pine N18E 21.33'; 11" J. Pine S78E 40.75'; 9" J. Pine S16W 49.93'; 13" J. Pine N71W 12.20'. Recorded in L.4 RC p.343.
(M11) Section corner common to Sections 25, 36, 30 and 31. 1983: David E. Erickson, RLS 29245. Set 5/8 X 36" rebar w/ cap witnessed by: 8" J. Pine N29E 34.86'; 8" J. Pine S79E 4.69'; 10" J. Pine S74W 25.05'; 9" J. Pine N78W 126.1'; 9" J. Pine N27W 17.39'. Recorded in L.4 RC p.349.
(16) East One-sixteenth corner common to Sections 25 and 36. Found 1/2" copper pipe 44.88 feet southerly of the monumented position.

B. Description of corner evidence found and/or method applied in restoring or reestablishing corner:

(L11) Found three of the witnesses as described, monument was missing. The witness NE is down with face and nail intact but unusable. The witness SW is gone with two stumps in close proximity to correct location. The SE witness is alive and standing in excellent condition and used to reset corner. The NW witness has been cut down, but the measuring nail is still in place on the stump. Reset a DNR monument from the two usable witnesses and from a pipe 43.02' south tied in by Erickson and rewitnessed.
(M11) Found DNR monument reset by Keith Sackett, RLS 19006 and two witnesses. Witnesses are cut about 5 feet high and are standing. Rewitnessed monument as found. Monument is on the north side of the ELF line at an angle point.
(16) Corner position established mid-point and on-line between the Southeast and South Quarter corners of Section 25. Rejected found copper pipe due to the excessive distance it is off line between corners.

C. Description of monument for corner and accessories established to perpetuate locating the position of the corner:

(L11) DNR monument
06" J. Pine N31E 23.85'
12" J. Pine S75E 40.75'
07" J. Pine S73W 67.6'
07" J. Pine N31W 59.35'
All trees are face and butt blazed, scribed 1/4S, NBT. Measurements are to notch in butt blaze, bearings are magnetic.
(M11) DNR monument
07" J. Pine N28E 11.9'
11" J. Pine S24E 125.1'
12" J. Pine S38W 114.9'
07" J. Pine N61W 128.6'
All trees are face and butt blazed, scribed with section number and NBT. Measurements are to notch in butt blaze, bearings are magnetic.
(16) DNR monument
10" J. Pine N61E 39.1'
10" J. Pine S34E 23.3'
07" J. Pine S48W 65.8'
04" J. Pine N87W 69.3'
All trees are face and butt blazed, scribed 1/16S, BT. Measurements are to notch in butt blaze, bearings are magnetic.

Signed by Paul R. Bressette Date
Surveyor's Michigan License No. 37270