


LAND CORNER RECORDATION CERTIFICATE
Filing Requirement of Act 74, Mich. P.A. 1970

For corners in
Marquette
(County)

Located In: Corner Code #/

- 1. Public Land Survey
2. Private Claims
S 24 T 46N R 28W 11
S 24 T 46N R 28W 12
S 24 T 46N R 28W 13

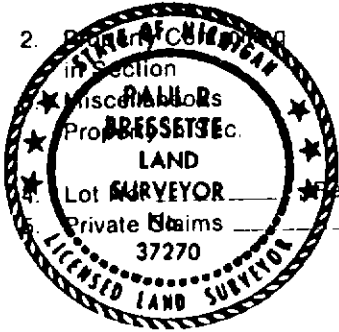

Register of Deeds Stamp & File Number

Recorded Plat

13 January 26, 1995
12 January 24, 1995

I, Paul R. Brissette, in a field survey on 11 January 24, 1995, 19 do hereby certify that under requirements of P.A. 74, Michigan P.A. of 1970, the corner points mentioned in lines 1 and 2 above were in conformance with regulations and rules therefore as required in the current manual of survey instructions of the United States Department of the Interior, Bureau of Land Management or by a decree of a Court of Law and/or that the corner points mentioned in lines 3, 4 and 5 above were in conformance with the rules of the Michigan Board of Land Surveyors or by a Decree of a Court of Law, established, re-established, monumented, re-monumented, recovered, found as expressed below.

NOTE: Not more than 4 corners, all in the same town and range, may be recorded on this certificate.

Grid table with columns A-M and rows 2-13. Contains numbers 1-36 and three dots in row 8, column J.

A. Description of original monument and accessories and/or subsequent restoration:

- (11) Southwest One-sixteenth corner of Section 24. Not set in original survey, no evidence of subsequent establishment.
(12) South One-sixteenth corner of Section 24. Found iron pin and iron pipe set by unknown person and not of record.
(13) Southeast One-sixteenth corner of Section 24. Not set in original survey, no evidence of subsequent establishment.

B. Description of corner evidence found and/or method applied in restoring or reestablishing corner:

- (11) Corner position established at the intersection of the west and south one-sixteenth lines of Section 24.
(12) Rejected iron pin and iron pipe since they do not conform to subdivision measurements. Corner position established mid-point and on-line between the center and south quarter corners of Section 24. Iron pipe is N69W 21.35 feet from monumented position, and the iron pin is S59E 11.98 feet from the monumented position.
(13) Corner position established at the intersection of the east and south one-sixteenth lines of Section 24. Corner falls in an alder swale.

C. Description of monument for corner and accessories established to perpetuate locating the position of the corner:

- (11) DNR monument: 18" J. Pine N32E 20.8', 6" J. Pine S32E 53.3', 8" J. Pine S66W 31.95', 8" J. Pine N53W 24.8'. All trees are face and butt blazed, scribed 1/16S, BT. Measurements are to notch in butt blaze. Bearings are magnetic.
(12) DNR monument: 18" J. Pine N39E 41.85', 8" J. Pine S66E 18.2', 8" J. Pine S40W 14.95', 3" J. Pine N55W 17.55'. All trees are face and butt blazed, scribed 1/16S, BT. Measurements are to notch in butt blaze, bearings are magnetic.
(13) DNR monument: 6" Jack Pine N50E 127.55', 3" Jack Pine S30E 76.4', 3" Jack Pine S01W 46.0', 9" Tamarack N64W 66.0'. All trees are face and butt blazed, scribed 1/16S, BT. Measurements are to notch in butt blaze. Bearings are magnetic.

Signed by Paul R. Brissette Date
Surveyor's Michigan License No. 37270