

MICHIGAN
DEPARTMENT OF CONSERVATION
FORESTRY DIVISION

LAND CORNER RECORD

T. 46 N. R. 29W


Marquette COUNTY

DESCRIPTION OF CORNER Sec. cor. common to secs. 11-12-13-14

CORNER MONUMENT 1" pipe with 4" aluminum cap.

DATE MONUMENT PLACED AND WITNESSED 10/11/66

WITNESSES TO CORNER..... 10" W. Pine (S11 NBT) N70°W, 15.7'

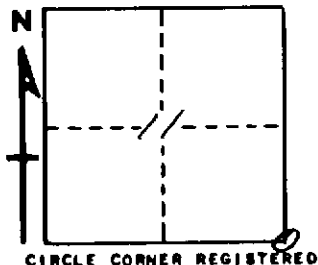

22" W. Pine (S13 NBT) S30°E, 28.8'

AND

DESCRIPTION IN DETAIL AS TO HOW CORNER WAS LOCATED AND IDENTIFIED OR RESTORED.

This corner replaced from remains of two original B.T.s a W.Pine bearing N49°W, 11 lks. and a cedar bearing S24°E, 27 lks., both trees down and badly rotted. Found some calloused overgrowth on the pine and the old chop marks on the cedar.

SURVEYOR'S SEAL

SIGNED Billy D. Buckles DATE 2/8/67
REGISTERED LAND SURVEYOR