

MICHIGAN
DEPARTMENT OF CONSERVATION
FORESTRY DIVISION

LAND CORNER RECORD

T. 46 N.R. 29W


Marquette COUNTY

DESCRIPTION OF CORNER South 1/16 corner bet. secs. 35-36

CORNER MONUMENT 1" pipe with 4" aluminum cap.

DATE MONUMENT PLACED AND WITNESSED 10/28/66

WITNESSES TO CORNER..... 18" Red Pine (1/16 BT) S29°W, 59.4'

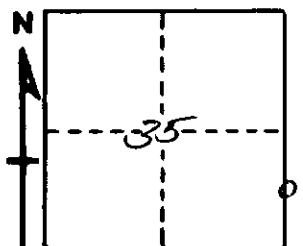

6" Soft Maple (BT) S87°E, 35.2'

AND

CIRCLE CORNER REGISTERED

DESCRIPTION IN DETAIL AS TO HOW CORNER WAS LOCATED AND IDENTIFIED OR RESTORED.

This corner established midway and on line bet. $\frac{1}{4}$ cor. to north and sec. cor. to south.

Cor. lies on open hillside facing south.

SURVEYOR'S SEAL

SIGNED Billy D. Buckler DATE 2/8/67
REGISTERED LAND SURVEYOR