

MICHIGAN  
DEPARTMENT OF CONSERVATION  
FORESTRY DIVISION

# LAND CORNER RECORD

T. 46 N.R. 29W


Marquette COUNTY

DESCRIPTION OF CORNER 1/4 cor. bet. secs. 35-36

CORNER MONUMENT 1" pipe with 4" aluminum cap.

DATE MONUMENT PLACED AND WITNESSED 10/28/66

WITNESSES TO CORNER..... 9" Red Pine (1/2 S NBT) S24°E, 9.8'

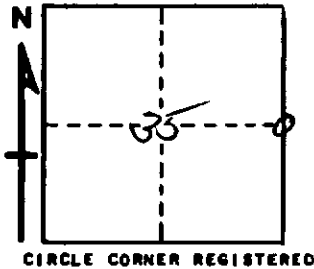

9" Red Pine (1/2 S NBT) N7°E, 17.8'

14" Jack Pine (1/2 S NBT) S20°W, 23.3'

AND

DESCRIPTION IN DETAIL AS TO HOW CORNER WAS LOCATED AND IDENTIFIED OR RESTORED.

This corner re-established midway and on line bet. two sec. cors.

Found no evidence of original cor.

Cor. lies 2.00 chs. north of Casey Lake Road.

SURVEYOR'S SEAL

SIGNED Billy D. Buckles DATE 2/8/67  
REGISTERED LAND SURVEYOR