

MICHIGAN  
DEPARTMENT OF CONSERVATION  
FORESTRY DIVISION

# LAND CORNER RECORD

T. 46N N.R. 29W


Marquette COUNTY

DESCRIPTION OF CORNER 1/2 cor. bet. Secs. 23-24

CORNER MONUMENT 1" pipe with 4" aluminum cap.

DATE MONUMENT PLACED AND WITNESSED 9/26/66

WITNESSES TO CORNER..... 10" Jack Pine (1/2 S NBT) N35°W, 7.1'

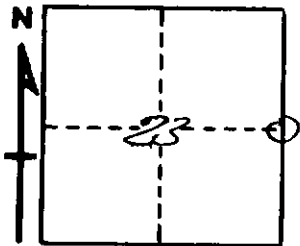

CIRCLE CORNER REGISTERED

5" B. Spruce (1/2 S NBT) N40°E, 15.9'

AND

DESCRIPTION IN DETAIL AS TO HOW CORNER WAS LOCATED AND IDENTIFIED OR RESTORED.

This corner replaced at old wood post, set by unknown surveyor.

Position checks well with Sec. Cor. 1/2 mile south. Corner found by survey crew while making a partial retracement of this township.

SURVEYOR'S SEAL

SIGNED Billy D. Buckler DATE 2/8/67  
REGISTERED LAND SURVEYOR