

MICHIGAN  
DEPARTMENT OF CONSERVATION  
FORESTRY DIVISION

# LAND CORNER RECORD

T. 46 N. R. 29W


Marquette COUNTY

DESCRIPTION OF CORNER 1/4 cor. bet. secs. 26-27

CORNER MONUMENT \_\_\_\_\_

DATE MONUMENT PLACED AND WITNESSED 10/28/66

WITNESSES TO CORNER..... 9" Jack Pine (1/2 S NBT) S20°E, 11.9'

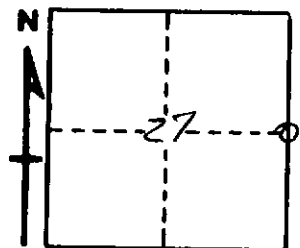

9" Jack Pine (1/2 S NBT) East 9.0'

AND

CIRCLE CORNER REGISTERED

DESCRIPTION IN DETAIL AS TO HOW CORNER WAS LOCATED AND IDENTIFIED OR RESTORED.

Rewitnessed this corner. Found squared jack pine with fence wire running south and west. Found old blazes to north and south. Distance north to swamp edge (3.00 chs.) agrees with record notes. Found remains of several yellow pines at 3.00 chs. + to south. Notes indicate a 10" Y. Pine line tree in this vicinity.

SURVEYOR'S SEAL

SIGNED

*Billy D. Buckler*  
REGISTERED LAND SURVEYOR

DATE

2/8/67