

LAND CORNER RECORDATION CERTIFICATE
Filing Requirement of Act 74, Mich. P.A. 1970

For corners in

Marquette <small>(County)</small>	Located In:	Corner Code <i>11</i>
1. Public Land Survey	T 47N R 23W	B-9
	T . . . R . . .	
	T . . . R . . .	
	T . . . R . . .	
2. Property Controlling in Section	S 30 T 47N R 23W	1,2
	S . . . T . . . R . . .	
3. Miscellaneous Property In Sec.	S . . . T . . . R . . .	
	S . . . T . . . R . . .	

Register of Deeds Stamp & File Number

4. Lot No. _____, Recorded Plat _____
 5. Private Claims _____

I, Paul R. Bressette, in a field survey on March 17, 19 92, do hereby certify that under requirements of P.A. 74, Michigan P.A. of 1970, the corner points mentioned in lines 1 and 2 above were in conformance with regulations and rules therefore as required in the current manual of survey instructions of the United States Department of the Interior, Bureau of Land Management or by a decree of a Court of Law and/or that the corner points mentioned in lines 3, 4 and 5 above were in conformance with the rules of the Michigan Board of Land Surveyors or by a Decree of a Court of Law; established, re-established, monumented, re-monumented, recovered, found as expressed below:

NOTE: Not more than 4 corners, all in the same town and range, may be recorded on this certificate.


	A	B	C	D	E	F	G	H	I	J	K	L	M
2	6	5	4	3	2								
3													
4	7	8	9	10	11	12							
5													
6	18	17	16	15	14	13							
7													
8	19	20	21	22	23	24							
9	•	•											
10	30	29	28	27	26	25							
11													
12	31	32	33	34	35	36							
13													

A. Description of original monument and accessories and/or subsequent restoration:

- B-9. One Quarter corner common to Sections 19 and 30. Wood post Sugar 22 N 13° W 10 lks
 Sugar 16 S 05° E 8 lks
- West One-sixteenth corner common to Sections 19 and 30. Not set in original survey, no evidence of subsequent establishment.
 - East One-sixteenth corner common to Sections 19 and 30. Not set in original survey, no evidence of subsequent establishment.

B. Description of corner evidence found and/or method applied in restoring or reestablishing corner:

- B-9. No evidence of wood post or OBT's found. Corner re-established by single proportionate measurement between the Northeast and Northwest corners of Section 30.
- Corner set by single proportionate measurement between the Northwest and North Quarter corners of Section 30. Corner falls at the north and east cutting edges of a clearcut.
 - Corner established mid-point and on-line between the Northeast and North Quarter corners of Section 30.

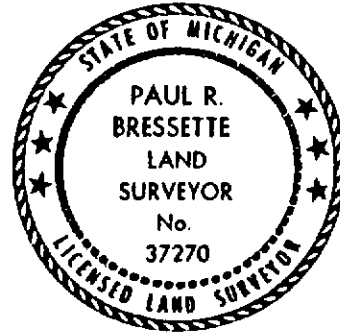

C. Description of monument for corner and accessories established to perpetuate locating the position of the corner:

- B-9. 1" pipe with 4" aluminum cap 4" Sugar maple (1/4S,BT) N 32° E 8.05';
 5" Sugar maple (1/4S,BT) S 57° E 9.5'; 6" Sugar maple (1/4S,BT) S 77° W 16.2';
 5" Sugar maple (1/4S,BT) N 27° W 9.05'.
- 1" pipe with 4" aluminum cap 10" White pine (1/16S,BT) N 56° E 45.15';
 11" Tamarack (1/16S,BT) S 74° E 51.9'; 5" White spruce (1/16S,BT) S 10° E 29.35';
 6" White spruce (1/16S,BT) N 28° W 33.3'.
 - 1" pipe with 4" aluminum cap 18" White spruce (1/16S,BT) N 42° E 59.5';
 8" White spruce (1/16S,BT) S 22° E 37.85'; 8" White birch (1/16S,BT) S 12° W 37.1';
 5" Balsam (1/16S,BT) N 76° W 43.45'.

Signed by Paul R. Bressette Date 9-28-92
 Surveyor's Michigan License No. 37270