

1994 DEC 28 PM 5:56

Patricia A. Manley
REGISTER OF DEEDS

LAND CORNER RECORDATION CERTIFICATE
Filing Requirement of Act 74, Mich. P.A. 1970

JOB NUMBER: 94030
SHEET NO. : 1-482
or corners in

<u>MARQUETTE</u> (County)	Located In:	Corner Code #
Public Land Survey	T <u>47N</u> R <u>24W</u>	M-9
	T <u>47N</u> R <u>23W</u>	<u>A-9</u>
	T _____ R _____	_____
	T _____ R _____	_____
Property Controlling	S _____ T _____ R _____	_____
in Section	S _____ T _____ R _____	_____
Miscellaneous	S _____ T _____ R _____	_____
Property in Sec.	S _____ T _____ R _____	_____

LIBER 1 PAGE 153
Register of Deeds Stamp & File Number

Lot No. _____, Recorded Plat _____
Private Claims _____

A	B	C	D	E	F	G	H	I	J	K	L	M
2	6	5	4	3	2	1						
3												
4	7	8	9	10	11	12						
5												
6	18	17	16	15	14	13						
7												
8	19	20	21	22	23	24						
9												
10	30	29	28	27	26	25						
11												
12	31	32	33	34	35	36						
13												

GERALD W. CARLSON, in a field survey on Tuesday, December 13, 1994,
hereby certify that under requirements of P.A. 74, Michigan P.A. of 1970, the corner points mentioned
in lines 1 and 2 above were in conformance with regulations and rules therefore as required in the
present manual of survey instructions of the United States Department of the Interior, Bureau of Land
Management or by a decree of a Court of Law and/or that the corner points mentioned in lines 3, 4 and 5
above were in conformance with the rules of the Michigan Board of Land Surveyors or by a Decree of a
Court of Law; established, re-established, monumented, re-monumented, recovered, found as
expressed below:

**NOTE: Not more than 4 corners, all in the same town and range, may be recorded
on this certificate.**

Description of original monument and accessories and/or subsequent restoration:

M-9: NE Corner of Section 25. 1844: William A. Burt's orig- 1988: Certificate of Survey recorded in Liber 001, Pg. 599
original survey notes describe the corner monument as a wood post by Glen C. Van Neste indicates the SW Corner of Section 19,
post referenced by: T47N-R23W as a found 2" iron pipe referenced by:
9" Sugar N67E, 10 L 14" Fir N46W, 13 L 11" Maple Az 34, 38.38' 3" Maple Az 143, 38.78'
1852: A.D. Sullivan's original subdivision survey notes for 7" Maple Az 230, 22.72' 11" Maple Az 353, 38.92'
T47N-R23W indicate the following additional references for 1992: Land Corner Recordation Certificate recorded by Paul
the NE Corner of Section 25, T47N-R24W: Bressette LLS No. 37270. Found a 2" iron pipe and witnesses
15" Sugar S63E, 33 L 10" Sugar N71E, 10 L as described in L. 1, Pg. 599, survey maps. (Record contin-
ued on reverse side).

Description of corner evidence found and/or method applied in restoring or reestablishing corner:

1994: Found and accepted DNR monument as referenced by Paul Bressette, P.S. No. 37270 in part A above.
Distance North is 2635.79' and distance South is 2643.30'.


RATIFIED BY PEER GROUP
P.A. 345 OF 1990

Larry J. Busone
DATE Oct 31, 1994

Description of monument for corner and accessories established to perpetuate locating the position of the corner:

1994 - Found a Department of Natural Resources iron pipe with 4" diameter aluminum cap in place referenced by nails in:
10" Maple S44W 22.66 ft. Bressette NBT
11" Maple N15W 38.80 ft. Bressette NBT
12" Maple N31E 38.82 ft. Bressette NBT
5" Maple S30E 39.02 ft. Bressette NBT
Steel sign post South 1.0 ft.
Monument is 1.0' East of a 5" diameter wood post. Stamped MCR 1994 on cap of monument (Marquette County
Remonumentation).
Bk. 5, Pg. 111

Recorded by Gerald W. Carlson Date 12-22-94
Surveyor's Michigan License No. 24589

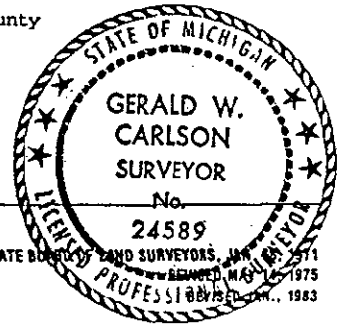

Record No. 482:

Part "A" Continued:

1992-Con't: Replaced found pipe with DNR monument and blazed upper and lower faces on NBTs. Measurements to notch in lower face. Referenced by:

10" Sugar	N45E,	38.25'
4" Sugar	S33E,	38.75'
8" Sugar	S49W,	22.4'
10" Sugar	N06W,	38.6'

L. 5 R.C., Pg. 358

*R.H. 6/14/92
Geo Rem*