

1994 DEC 28 PM 5:56

Patricia A. Monney REGISTER OF DEEDS

JOB NUMBER: 94030 SHEET NO.: 1-484

LAND CORNER RECORDATION CERTIFICATE Filing Requirement of Act 74, Mich. P.A. 1970

or corners in

Form with fields for Located In: MARQUETTE (County), Corner Code #, and a table for Public Land Survey, Property Controlling in Section, Miscellaneous, and Property in Sec. with T/R/S coordinates.

LIBER 1 PAGE 155 Register of Deeds Stamp & File Number

Lot No. Recorded Plat Private Claims

Grid table with columns A-M and rows 2-13, containing numbers 1-36.

GERALD W. CARLSON, in a field survey on Tuesday, December 13, 1994, hereby certify that under requirements of P.A. 74, Michigan P.A. of 1970, the corner points mentioned in lines 1 and 2 above were in conformance with regulations and rules therefore as required in the rent manual of survey instructions of the United States Department of the Interior, Bureau of Land Management or by a decree of a Court of Law and/or that the corner points mentioned in lines 3, 4 and 5 above were in conformance with the rules of the Michigan Board of Land Surveyors or by a Decree of a Court of Law; established, re-established, monumented, re-monumented, recovered, found as pressed below:

NOTE: Not more than 4 corners, all in the same town and range, may be recorded on this certificate.

Description of original monument and accessories and/or subsequent restoration:

M-11: NE Corner of Section 36. 1844: William A. Burt's original survey notes describe the corner monument as a wood post referenced by: 16" Birch N60E, 39 L 14" Hemlock N49W, 48 L 1852: A.D. Sullivan's original subdivision survey notes for T47N-R23W indicate the following additional references for the NE Corner of Section 36, T47N-R24W: 22" Hemlock S37E, 53 L 14" Birch N62E, 35 L 1992: LCRC, by Paul R. Bressette LLS No. 37270. Found 1" iron pipe, location poster and several trees with old blazes. Distance North to 1/4 Corner set from original evidence 2650.87' (GLO 2640) and South to 1. bank Chocolay River 1729.49' (GLO 1725.9'). Cedar stump for line tree found +/- 50' South of riverbank and on-line between found iron and iron set by RLS 17618. Distance to found iron to South 5288.57' (GLO 5280). Proportioned Distances to found iron, riverbank, and Cedar stump fit almost exactly. (See Reverse)

Description of corner evidence found and/or method applied in restoring or reestablishing corner:

1994: Found and accepted DNR monument as referenced by Paul Bressette in Part A above. Distance North is 2650.75 and distance South is 2644.65'.

RATIFIED BY PEER GROUP P.A. 345 OF 1990

DATE 10/31/1994

Description of monument for corner and accessories established to perpetuate locating the position of the corner:

1994 - Found Department of Natural Resources iron pipe with 4" diameter aluminum cap in place referenced by nails in: 9" Maple N64W 7.73 ft. Bressette NBT 7" Spruce N12E 39.85 ft. Bressette NBT 5" Maple S16E 5.19 ft. Bressette NBT 8" Cedar S31W 52.72 ft. Bressette NBT Steel sign post Northeast 1.0 ft.


Monument is 1.0' East of a 3" diameter wood post. Stamped MCR 1994 on cap of monument (Marquette County re-monumentation).

Book 5, Pg. 115

by Gerald W. Carlson

Date 12-22-94

Surveyor's Michigan License No. 24589

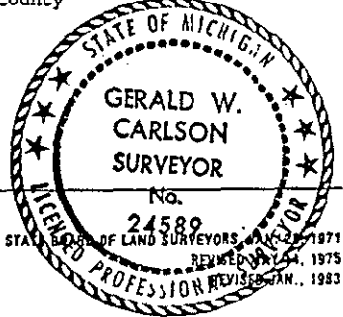

Record No. 484:

Part "A" Continued:

1992-Con't: Replaced iron pipe with DNR monument and witnessed. Corner falls 124' North of abandoned RR grade. Referenced by:

6" W. Spruce	N19E,	39.7'
4" Sugar	S12E,	5.0'
16" Cedar	S34W,	51.5'
8" Sugar	N54W,	7.35'

L. 5 R.C., Pg. 360.

*24 644
90
200 Rm*