

LAND CORNER RECORDATION CERTIFICATE
Filing Requirement of Act 74, Mich. P.A. 1970

For corners in Marquette (County) Located in: Corner Code #
1. Public Land Survey T R
2. Property Controlling in Section S 14 T 47N R 25W 14
3. Miscellaneous Property in Sec. S T R

Register of Deeds Stamp & File Number

4. Lot No. Recorded Plat
5. Private Claims

15 Jul 09 1996
14 Jul 16 1996

I, Paul R. Bressette, in a field survey on 19 do hereby state that under requirements of P.A. 74, Michigan P.A. of 1970, the corner points mentioned in lines 1 and 2 above were in conformance with regulations and rules therefore as required in the current manual of survey instructions of the United States Department of the Interior, Bureau of Land Management or by a decree of a Court of Law and for that the corner points mentioned in lines 3, 4 and 5 above were in conformance with the rules of the Michigan Board of Land Surveyors or by a Decree of a Court of Law; established, re-established, monumented, recovered, found as expressed below:


NOTE: Not more than 2 corners, all in the same town and range, may be recorded on this certificate.

Grid table with columns A-M and rows 1-13. Contains numbers 1-36 and two dots in the grid.

- A. Description of original monument and accessories and/or subsequent restoration:
(14) South One-sixteenth corner common to Sections 13 and 14. Found 1" iron pipe, not of record.
(15) West One-sixteenth corner common to Sections 14 and 23. Found 1" iron pipe, not of record.

- B. Description of corner evidence found and/or method applied in restoring or reestablishing corner:
(14) Rejected iron pipe due to excessive distance from calculated position. Pipe falls 8.09 feet north of calculated position. Corner position established mid-point and on-line between the East Quarter and Southeast corners of Section 14.
(15) Rejected iron pipe due to excessive distance from calculated position. Pipe falls N09W (magnetic) 46.0 feet from calculated position. Corner position established mid-point and on-line between the South Quarter and Southwest corners of Section 14.

- C. Description of monument for corner and accessories established to perpetuate locating the position of the corner:
(14) DNR monument
06" R.Maple N35E 15.9' (1/16S,BT)
14" W.Pine S22E 42.0' (1/16S,BT)
06" W.Pine S53W 22.5' (1/16S,BT)
08" R.Maple N28W 45.1' (1/16S,BT)
All trees are blazed, scribed and painted. Measurements are to notch in butt blaze, bearings are magnetic.
(15) DNR monument
14" Oak N55E 47.45' (1/16S,BT)
10" Oak S03E 21.8' (1/16S,BT)
08" Oak S39W 37.4' (1/16S,BT)
12" Oak N31W 82.6' (1/16S,BT)
All trees are blazed, scribed and painted. Measurements are to notch in butt blaze, bearings are magnetic.

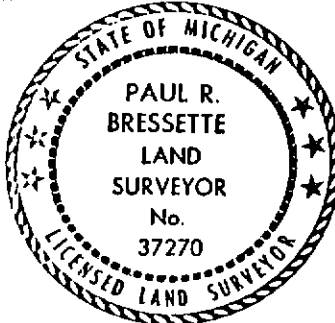

Signed by Paul R. Bressette Date 1-13-97
Surveyor's Michigan License No. 37270