

APR 01 1996
 COMMISSION

JOB NUMBER: 95053
 SHEET NO. : 1-623

LAND CORNER RECORDATION CERTIFICATE

Filing Requirement of Act 74, Mich. P.A. 1970

MARQUETTE COUNTY
 MICHIGAN
 RECEIVED FOR RECORD
 MARQUETTE COUNTY
 1995 DEC 27 AM 7:44
 RECEIVED FOR RECORD

For corners in

MARQUETTE
 (County)

Located In:

Corner Code #

- | | | | |
|--------------------------------------|-------|-------|-------|
| 1. Public Land Survey | T 47N | R 26W | M-8 |
| | T 47N | R 25W | A-8 ✓ |
| | T | R | |
| | T | R | |
| 2. Property Controlling in Section | S | T | R |
| | S | T | R |
| 3. Miscellaneous Property in Section | S | T | R |
| | S | T | R |

1995 DEC 27
 REGISTER OF DEEDS
 Patricia A. Monley
 REGISTER OF DEEDS

LIBER 1 PAGE 241

Register of Deeds Stamp & File Number

4. Lot No. _____, Recorded Plat _____
 5. Private Claims _____

I, GERALD W. CARLSON, in a field survey on Tuesday, November 7, 1995, do hereby certify that under requirements of P.A. 74, Michigan P.A. of 1970, the corner points mentioned in lines 1 and 2 above were in conformance with regulations and rules therefore as required in the current manual of survey instructions of the United States Department of the Interior, Bureau of Land Management or by a decree of a Court of Law and/or that the corner points mentioned in lines 3, 4 and 5 above were in conformance with the rules of the Michigan Board of Professional Surveyors or by a Decree of a Court of Law; established, re-established, monumented, re-monumented, recovered, found as expressed below:

A	B	C	D	E	F	G	H	I	J	K	L	M
2	6		5		4		3		2		1	
3												
4	7		8		9		10		11		12	
5												
6	18		17		16		15		14		13	
7												
8	19		20		21		22		23		24	
9												
10	30		29		28		27		26		25	
11												
12	31		32		33		34		35		36	
13												

NOTE: Not more than 4 corners, all in the same town and range, may be recorded on this certificate.

Description of original monument and accessories and/or subsequent restoration:


M-8: Quarter Corner common to Section 24, T47N-R26W and Sec- references: tion 19, T47N-R25W. 1844: William A. Burt's original survey 8" J. Pine N80E, 20.46' notes describe the corner monument as a wood post referenced 12" W. Pine S15W, 30.35' by: 1951: MCRC P.B. #651 (No page given) indicates the corner and references as recorded above in Record of Surveys Book #1, Pg. 113.
 1951: The corner is indicated as a 1" pipe with 4" brass cap on a Land Corner Record recorded by the Michigan Department of Conservation Forestry Division (Dean C. De La Mater RLS #05778), in Record of Surveys Book #1, Pg. 113. Established

Description of corner evidence found and/or method applied in restoring or reestablishing corner:

1995: Found and accepted a stamped 4" Michigan Department of Conservation Brass Tablet on a 2" diameter galvanized pipe, 1.5' above ground. Distance North is 2616.93', and Distance South is 2637.19'.

RATIFIED BY PEER GROUP
 P.A. 345 OF 1990

Larry J. Bussone
 DATE 11/13/95

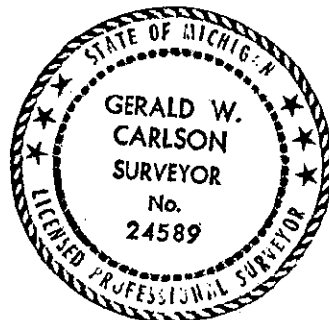

Description of monument for corner and accessories established to perpetuate locating the position of the corner:

1995: Checked existing N.B.T. and established new references to found 4" diameter Brass Capped Monument:
 8" J. Pine(M.D.O.C. N.B.T., blazed and scribed 5.5' stump) N81E, 21.05' (Set duplex nail); 20.7' (Old Face Blaze)
 5" Trip. Oak S52E, 39.42'
 7" W. Pine S47E, 31.96'
 12" W. Pine N88W, 73.17'
 16" W. Pine N70W, 83.30'
 Green Steel Sign Post w/Yellow Survey Marker Sign North, 1.0'
 Note: Bearing Trees were face and butt blazed, painted, and B.T. Tags affixed. Distances are to set duplex nails.
 Bk. 9, pp. 49-52.

Signed by *Gerald W. Carlson*

Date 12-15-95

Surveyor's Michigan License No. 24589