

APR 1 1996

JOB NUMBER: 95053
SHEET NO. : 1-627

COMMISSION

LAND CORNER RECORDATION CERTIFICATE
Filing Requirement of Act 74, Mich. P.A. 1970

MARQUETTE COUNTY
MICHIGAN
RECEIVED FOR RECORD
1995 DEC 27 AM 7:45
William A. Burt
REGISTER OF DEEDS

For corners in

MARQUETTE
(County)

Located In:

Corner Code #

1. Public Land Survey

T 47N	R 26W	M-12
T 47N	R 25W	M-12 ✓
T	R	
T	R	

2. Property Controlling
in Section

S	T	R
S	T	R

3. Miscellaneous
Property in Section

S	T	R
S	T	R

LIBER 1 PAGE 245
Register of Deeds Stamp & File Number

4. Lot No. _____, Recorded Plat _____
5. Private Claims _____

A	B	C	D	E	F	G	H	I	J	K	L	M
2	6	5	4	3	2	1						
3												
4	7	8	9	10	11	12						
5												
6	18	17	16	15	14	13						
7												
8	19	20	21	22	23	24						
9												
10	30	29	28	27	26	25						
11												
12	31	32	33	34	35	36						
13												

I, GERALD W. CARLSON, in a field survey on Tuesday, November 28, 1995, do hereby certify that under requirements of P.A. 74, Michigan P.A. of 1970, the corner points mentioned in lines 1 and 2 above were in conformance with regulations and rules therefore as required in the current manual of survey instructions of the United States Department of the Interior, Bureau of Land Management or by a decree of a Court of Law and/or that the corner points mentioned in lines 3, 4 and 5 above were in conformance with the rules of the Michigan Board of Professional Surveyors or by a Decree of a Court of Law; established, re-established, monumented, re-monumented, recovered, found as expressed below:

NOTE: Not more than 4 corners, all in the same town and range, may be recorded on this certificate.

A. Description of original monument and accessories and/or subsequent restoration:

M-12: Quarter Corner common to Section 36, T47N-R26W and Section 31, T47N-R25W. 1844: William A. Burt's original survey notes describe the corner monument as a wood post referenced by:
4" S. Pine S63E, 14 l
4" S. Pine N40W, 20 l

B. Description of corner evidence found and/or method applied in restoring or reestablishing corner:

1995: Searched, and no subsequent evidence or corner found. Corner position established by single proportion measurement on line between the S.E. and N.E. Corners of Section 36. Distance North is 2643.14', and Distance South is 2643.14'.

RATIFIED BY PEER GROUP
P.A. 345 OF 1990


Larry J. Bussone
DATE 11/13/95

C. Description of monument for corner and accessories established to perpetuate locating the position of the corner:

1995: Set a 2 3/8" O.D. aluminum pipe capped with a 3 1/4" diameter aluminum tablet Marquette County Survey Monument stamped to identify the corner. Monument is 6" below surface in S'LY rut of 2-track road. Referenced by double headed nails set in:

7" J. Pine	N75W,	11.31'
8" J. Pine	Due North,	35.33'
8" J. Pine	N65E,	33.16'
7" J. Pine	S15W,	37.95'
Green Steel Sign Post w/Yellow Survey Marker Sign	East,	14.0'

Note: Bearing Trees were face and butt blazed, and had bearing tree tags affixed.
Bk. 9, pp. 67-68.

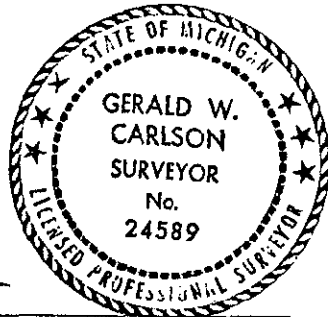

Signed by Gerald W. Carlson

Date 12-15-95

Surveyor's Michigan License No. 24589