

SECTION
 1-833

MARQUETTE COUNTY
 MICHIGAN
 RECEIVED FOR RECORD
 1998 DEC 29 PM 3:23

LAND CORNER RECORDATION CERTIFICATE
 Filing Requirement of Act 74, Mich. P.A. 1970

For corners in MARQUETTE Located In: Corner Code #
 (County)

1. Public Land Survey T 47N R 25W K-6
 T _____ R _____
 T _____ R _____
 T _____ R _____

2. Property Controlling S _____ T _____ R _____
 in Section S _____ T _____ R _____

3. Miscellaneous S _____ T _____ R _____
 Property in Sec. S _____ T _____ R _____

4. Lot No. _____, Recorded Plat _____

5. Private Claims _____

Patricia A. Monney
 REGISTER OF DEEDS

LIBER R 2 PAGE 121

Register of Deeds Stamp & File Number

A	B	C	D	E	F	G	H	I	J	K	L
1											
2	6	5	4	3	2	1					
3											
4	7	8	9	10	11	12					
5											
6	18	17	16	15	14	13					
7											
8	19	20	21	22	23	24					
9											
10	30	29	28	27	26	25					
11											
12	31	32	33	34	35	36					
13											

I, GERALD W. CARLSON, in a field survey on SEPTEMBER 29th, 19 98, do hereby state that under requirements of P.A. 74, Michigan P.A. of 1970, the corner points mentioned in lines 1 and 2 above were in conformance with regulations and rules therefore as required in the current manual of survey instructions of the United States Department of the Interior, Bureau of Land Management or by a decree of a Court of Law and/or that the corner points mentioned in lines 3, 4 and 5 above were in conformance with the rules of the Michigan Board of Land Surveyors or by a Decree of a Court of Law; established, re-established, monumented, recovered, found as expressed below:

NOTE: Not more than 2 corners, all in the same town and range, may be recorded on this certificate.

A. Description of original monument and accessories and/or subsequent restoration:
 K-6: Quarter Corner common to Sections 13 and 14.

1845: A.D. Sullivan's original subdivision survey notes describe the corner monument as a wood post referenced by:
 12" Hemlock S80E, 41 L 6" Maple N83W, 12 L

No date: MCRC Government Corner Index Book #651 for Section 13 indicates the corner as a 1" iron pipe and maple post about 15' North of road. Referenced by:
 6" Maple N70W, 47.6' 5" Maple N73E, 42.4'

1989: A Certificate of Survey recorded by Glenn C. Van Neste P.S. #27464 in L. 001, SM pg. 614, indicates the corner as a found 1 1/4" Pipe with RLS Cap #24589. Distance N00-36'-33"W, 2647.76' to a fd. 5/8" iron at the N.W. Corner of section 13. Fd. 1 1/4" capped pipe referenced by:
 12" Maple Az 84, 42.74' (MCRC NBT) 5" Maple Az 189, 38.61'
 7" W. Birch Az 268, 52.51' 8" Maple Az 342, 15.43'
 C/L 2-Track Rd. AZ 189, 15.0' (MCRC Accessory)


1997: An LCRC recorded by Paul Bressette, PS No. 37270 indicates he replaced a found 1 1/4" Iron Pipe with plastic cap (RLS 24589) with a DNR monument referenced by:
 14" R. Maple N85E, 42.69' (1/4 S, NBT) 6" Maple S11W, 38.56' (1/4 S, NBT)
 8" W. Birch N88W, 52.47' (1/4 S, NBT) 9" R. Maple N16W, 15.36' (1/4 S, NBT)

B. Description of corner evidence found and/or method applied in restoring or reestablishing corner:
 K-6: 1998: No original corner evidence found. Found and accepted the 3 1/2" diameter Michigan Dept. of Natural Resources aluminum tablet stamped to identify the corner (Bressette, 37270) referenced in Part "A" above. Checked line calls South, 11.00 chains to stream 15L (726'-R, 731'-M), North, 4.00 chains to stream 5 L (264'-R, 265'-M). Distance North is 2647.65' and distance South is 2630.80'

C. Description of monument for corner and accessories established to perpetuate locating the position of the corner:
 K-6: 1998: Found 1 1/2" O.D. Pipe w/ 3 1/2" diameter aluminum tablet DNR Monument Stamped to identify the corner. Monument is 0.20' above ground. Measured existing references:
 13" Maple N85E, 42.72' (Bressette NBT) 6" Maple S07W, 38.60' (Bressette NBT)
 7" W. Birch S87W, 52.48' (Bressette NBT) 9" Maple N18W, 15.38' (Bressette NBT)
 C/L two track road South, 15'
 Cedar Post w/ Yellow Survey Marker Sign, North, 0.85'.

Note: Bearing trees have painted face, butt, and side nail blazes, d.h. measuring nails, and stamped B.T. Tags affixed. The NBT's are all scribed.

RATIFIED BY PEER GROUP
 P.A. 345 OF 1990
Larry J. Bussone
 DATE 12/21/98

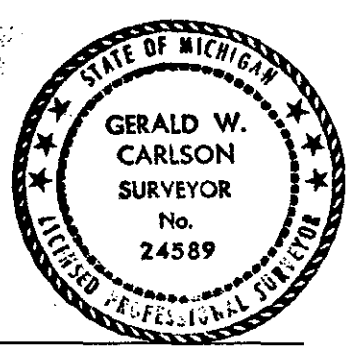

Signed by Gerald W. Carlson Date 12-28-98

Surveyor's Michigan License No. 24589 FORM APPROVED BY MICHIGAN STATE BOARD OF PROFESSIONAL SURVEYORS, JAN. 28, 1971