

MAR 1 1999

MARQUETTE COUNTY MICHIGAN RECEIVED FOR RECORD

1999 DEC 22 AM 11: 27

SECTION

LAND CORNER RECORDATION CERTIFICATE Filing Requirement of Act 74, Mich. P.A. 1970

Patricia A. Manley REGISTER OF DEEDS

For corners in MARQUETTE (County) Located In: Corner Code # 1. Public Land Survey T 47N R 25W L-13 2. Property Controlling in Section S T R 3. Miscellaneous Property in Sec. S T R 4. Lot No. , Recorded Plat 5. Private Claims

LIBER R2 PAGE 226 Register of Deeds Stamp & File Number

I, GERALD W. CARLSON, in a field survey on December 2, 19 99, do hereby state that under requirements of P.A. 74, Michigan P.A. of 1970, the corner points mentioned in lines 1 and 2 above were in conformance with regulations and rules therefore as required in the current manual of survey instructions of the United States Department of the Interior, Bureau of Land Management or by a decree of a Court of Law and/or that the corner points mentioned in lines 3, 4 and 5 above were in conformance with the rules of the Michigan Board of Land Surveyors or by a Decree of a Court of Law; established, re-established, monumented, recovered, found as expressed below:

NOTE: Not more than 2 corners, all in the same town and range, may be recorded on this certificate.

A. Description of original monument and accessories and/or subsequent restoration: L-13: South Quarter Corner to Section 36, T47N-R25W, 1844: William A. Burt's original township boundary survey notes describe the corner monument as a wood post referenced by: 4" Fir N53E, 17L 9" Fir N52W, 16L

B. Description of corner evidence found and/or method applied in restoring or reestablishing corner: L-13: 1999: No original corner evidence found. Corner position established by single proportionate measurement on line between the Southwest and Southeast corners of Section 36, T47N-R25W. Distances are 2624.26' West and 2624.26' East along the South Township Line of T47N-R25W to the Southwest and Southeast corners of Section 36. The North quarter corner of Section 1 is East 4.62'.


C. Description of monument for corner and accessories established to perpetuate locating the position of the corner: L-13: 1999: Set a 2 3/8" O.D. aluminum pipe capped with a 3 1/4" diameter aluminum tablet Marquette County Survey Monument stamped to identify the corner. Monument is 0.40' above ground. Referenced by: 5" Maple S78W, 9.34' 6" White Pine N50W, 8.45' 7" Maple N25E, 10.73' 10" White Birch S30W, 5.22'

Green Steel Sign Post w/ Yellow Survey Marker Sign Due North, 3.00'

Note: Bearing trees have painted face, butt, and side nail blazes, d.h. measuring nails, and stamped B.T. Tags affixed. Bk.12, Pg. 152-153

Grid table with columns A-M and rows 1-13. A dot is present in cell L13.

RATIFIED BY PEER GROUP P.A. 345 OF 1990 Larry J. Bussine 11/1/99

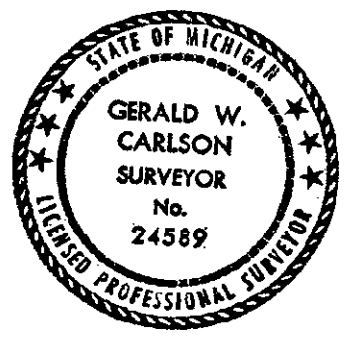

Signed by Gerald W. Carlson Date 12-8-99