

1994 DEC 28 PM 5: 51

Patricia L. M... REGISTER OF DEEDS

JOB NUMBER: 94030 SHEET NO. : 1-501

LAND CORNER RECORDATION CERTIFICATE Filing Requirement of Act 74, Mich. P.A. 1970

For corners in

Table with columns: MARQUETTE (County), Located In:, Corner Code #. Row 1: Public Land Survey, T 47N, R 26W, M-11 (circled), A-11 (checked).

LIBER 1 PAGE 171 Register of Deeds Stamp & File Number

4. Lot No. , Recorded Plat 5. Private Claims

GERALD W. CARLSON, in a field survey on Friday, December 16, 1994, hereby certify that under requirements of P.A. 74, Michigan P.A. of 1970, the corner points mentioned in lines 1 and 2 above were in conformance with regulations and rules therefore as required in the current manual of survey instructions of the United States Department of the Interior, Bureau of Land Management or by a decree of a Court of Law and/or that the corner points mentioned in lines 3, 4 and 5 above were in conformance with the rules of the Michigan Board of Land Surveyors or by a Decree of a Court of Law; established, re-established, monumented, re-monumented, recovered, found as expressed below:

Grid table with columns A-L and rows 2-13. Contains numbers 1-36 in a grid pattern.

NOTE: Not more than 4 corners, all in the same town and range, may be recorded on this certificate.

Description of original monument and accessories and/or subsequent restoration:

- M-11: NE Corner of Section 36, 10" Spruce S65E 28 1
1844: William A. Burt's original survey notes described a 12" Sugar N65E 09 1 corner monument as a post on South side of hill
1910: County survey by Charles Cummings of Section 30 T47N-R26W indicates the line run East from the SW corner, set from 24" Pine S50W 10 1
1933: M.C.R.C. FB 545 indicates NW Corner of Section 31, T47N-R26W as an eye bar on South exposure of high hill about 60' West of South side of large granite outcrop. Set correctly in accordance with the US field notes. (See reverse side).

Description of corner evidence found and/or method applied in restoring or reestablishing corner:


1994: During remonumentation survey found corner position to be inaccessible due to mining operations overburden pile. A Witness Corner was placed on the Section Line 360.00' South of the position of the Northeast Corner of Section 36, T47N-R27W. The position of the corner was calculated using the ECI double proportion survey - 1978. This calculated position checked to the South 1/4 Corner of Section 30, T47N-R26W within 0.47' and to a CCI control point (MPL10) to within 0.56'. Both measured distances were short of record and it was determined to accept this position as it matched the recent surveys conducted in the area. Distance South is 2236.12' and distance North is 2632.73'.

RATIFIED BY PEER GROUP P.A. 245 OF 1990 Larry J. Beresone DATE Dec 19, 1994

Description of monument for corner and accessories established to perpetuate locating the position of the corner:

- 1994 - Set a 2 1/2" diameter aluminum pipe capped with a 3 1/4" diameter aluminum tablet Marquette County Survey Monument stamped to identify the corner referenced by nails in:
8" Forked Cherry S57W 155.80 ft.
6" Oak S63W 133.21 ft.
3" Maple N80W 21.47 ft. (cluster of 6 trees)
Power Pole N45E 131.70 ft.
Steel sign post Northwest 1.0 ft.
Monument is 0.40' above ground and is located 20.7' Southeast of a rock cliff and 44.0' Northwest of centerline of the paved road between the Tilden and Empire Mines. Bk. 5, Pg. 39

By Gerald W. Carlson Date 12-22-94 Surveyor's Michigan License No. 24589

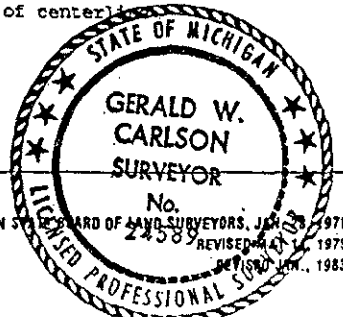

Record No. 501

No corner accessories given.

No date given: The Cleveland Cliffs Iron Company triangulation coordinates assigned for the NE Corner of Section 36, T47N-R27W as South 26083.29 and West 4852.95.

*Plt 64
Geo Rem*