

# SURVEY & REMONUMENTATION

MARQUETTE COUNTY  
MICHIGAN  
RECEIVED FOR RECORD

JOB NUMBER: 94030  
SHEET NO. : 1-499

**APR 28 1995** LAND CORNER RECORDATION CERTIFICATE  
Filing Requirement of Act 74, Mich. P.A. 1970

1994 DEC 28 PM 5: 57

For corners in

**COMMISSION**

*Patricia A. Monley*  
REGISTER OF DEEDS

MARQUETTE  
(County)


Located In:

Corner Code:##

1. Public Land Survey	T	47N	R	27W	M-13
	T	47N	R	26W	A-13 ✓
	T	46N	R	26W	A-1
	T	46N	R	27W	M-1
2. Property Controlling in Section	S		T		R
3. Miscellaneous Property in Sec.	S		T		R

LIBER **1** PAGE **169**  
Register of Deeds Stamp & File Number

4. Lot No. \_\_\_\_\_, Recorded Plat \_\_\_\_\_  
5. Private Claims \_\_\_\_\_

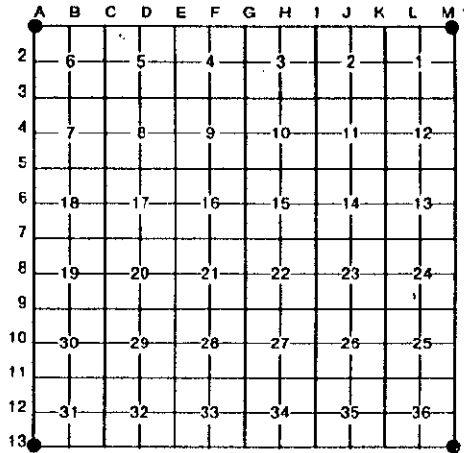

I, GERALD W. CARLSON, in a field survey on Friday, December 16, 1994, do hereby certify that under requirements of P.A. 74, Michigan P.A. of 1970, the corner points mentioned in lines 1 and 2 above were in conformance with regulations and rules therefore as required in the current manual of survey instructions of the United States Department of the Interior, Bureau of Land Management or by a decree of a Court of Law and/or that the corner points mentioned in lines 3, 4 and 5 above were in conformance with the rules of the Michigan Board of Land Surveyors or by a Decree of a Court of Law; established, re-established, monumented, re-monumented, recovered, found as expressed below:

**NOTE: Not more than 4 corners, all in the same town and range, may be recorded on this certificate.**

**A. Description of original monument and accessories and/or subsequent restoration:**

M-13: Section Corner common to Section 36, T47N-R27W Section 31, T47N-R26W, Section 6, T46N-R26W, Section 1, T46N-R27W.  
1844: William A. Burt's original survey notes indicated he intersected at temporary T.COR. and established Corner of Twp. 46 & 47 North. Between Rs. 26 & 27 West referenced by:  
18" White Pine S21W 17 l  
10" Black Oak N20E 16 l

1846: Austin Burt's original town line survey of the South boundary of T47N-R27W indicate a post for the Corner of T46N & T47N - R26W & R27W with the same identical bearing trees established by William A. Burt in 1844.  
1932: M.C.R.C. field book no. 545 indicates the NW Corner of Section 6, T46N-R27W as a fence post at fence intersection. Cannot be proven by US field notes. Very little topography given but appears to be about right. A few Black Oak on this hillside and none in the near vicinity. (See reverse side).

**B. Description of corner evidence found and/or method applied in restoring or reestablishing corner:**


1994: Found and accepted 1/2" re-rod as referenced in part "A" above. Distance West is 2637.37' and distance North is 2596.12'.

**DATED BY PEER GROUP  
P.A. 345 OF 1990**

*Larry J. Bussone*  
DATE Dec 6, 1994

**C. Description of monument for corner and accessories established to perpetuate locating the position of the corner:**

1994 - Replaced 1/2" iron and cap #15415 with a 2 1/2" diameter aluminum pipe capped with a 3 1/4" diameter aluminum tablet Marquette County Survey Monument stamped to identify the corner referenced by nails in:  
Power pole S43W 44.79 ft. Clark NBT  
Power pole S15E 33.20 ft. Clark NBT  
Rock face N15E 18.84 ft. Clark Accessory (spike in rock)  
7" Oak S44E 112.63 ft.  
5" Oak S52E 106.18 ft.  
Steel sign post Northeast 1.0 ft.  
Monument is 0.40' above ground and in power line. BK. 5, Pg. 41

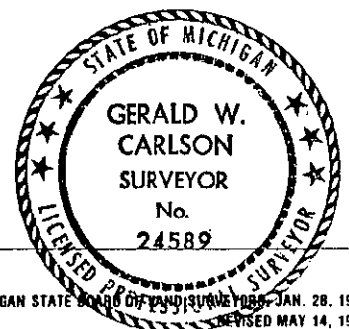

Signed by Gerald W. Carlson Date 12-22-94  
Surveyor's Michigan License No. 24589