

**SURVEY &
REMONUMENTATION**

APR 28 1995

JOB NUMBER: 94030

SHEET NO. : 1-524

COMMISSION

LAND CORNER RECORDATION CERTIFICATE

Filing Requirement of Act 74, Mich. P.A. 1970

MARQUETTE COUNTY
MICHIGAN
RECEIVED FOR RECORD

1994 DEC 28 PM 5:58

For corners in

<u>MARQUETTE</u> (County)	Located In:	Corner Code #
1. Public Land Survey	T <u>47N</u> R <u>26W</u>	<u>H-1</u>
	T _____ R _____	_____
	T _____ R _____	_____
	T _____ R _____	_____
2. Property Controlling in Section	S _____ T _____ R _____	_____
	S _____ T _____ R _____	_____
3. Miscellaneous Property In Sec.	S _____ T _____ R _____	_____
	S _____ T _____ R _____	_____

*Patricia R. M...
REGISTER OF DEEDS*

LIBER **1** PAGE **190**
Register of Deeds Stamp & File Number

4. Lot No. _____, Recorded Plat _____
5. Private Claims _____

A	B	C	D	E	F	G	H	I	J	K	L	M
2	6	5	4	3	2	1						
3												
4	7	8	9	10	11	12						
5												
6	18	17	16	15	14	13						
7												
8	19	20	21	22	23	24						
9												
10	30	29	28	27	26	25						
11												
12	31	32	33	34	35	36						
13												

I, GERALD W. CARLSON, in a field survey on Thursday, December 22, 1994, do hereby certify that under requirements of P.A. 74, Michigan P.A. of 1970, the corner points mentioned in lines 1 and 2 above were in conformance with regulations and rules therefore as required in the *current manual of survey instructions of the United States Department of the Interior, Bureau of Land Management* or by a decree of a Court of Law and/or that the corner points mentioned in lines 3, 4 and 5 above were in conformance with the rules of the Michigan Board of Land Surveyors or by a Decree of a Court of Law; established, re-established, monumented, re-monumented, recovered, found as expressed below:


NOTE: Not more than 4 corners, all in the same town and range, may be recorded on this certificate.

A. Description of original monument and accessories and/or subsequent restoration:
H-1: North 1/4 Corner Section 3, T47N-R26W.
Not part of original survey.

B. Description of corner evidence found and/or method applied in restoring or reestablishing corner:
1994: Corner position established equidistant between the Northeast and Northwest Corners of Section 3 and on line between the Southwest and Southeast Corners of Section 34, T48N-R26W. Distances West and East are 2634.08'.
The South 1/4 Corner of Section 34, T48N-R26W is West 21.47'.

**RATIFIED BY PEER GROUP
P.A. 345 OF 1990**
Larry J. Bussem
DATE Dec 6, 1994

C. Description of monument for corner and accessories established to perpetuate locating the position of the corner:
1994 - Set a 2 1/2" diameter aluminum pipe capped with a 3 1/4" diameter aluminum tablet Marquette County Survey Monument stamped to identify the corner referenced by nails in:
8" Balsam N20W 43.25 ft.
9" White Spruce N25E 15.64 ft.
9" White Spruce S58E 27.75 ft.
7" White Pine S34W 20.29 ft.
Steel sign post N76E 2.57 ft.
Monument is 0.45' above ground and is on Easterly side of +/- 20' high hill.
Bk. 9, Pg. 7

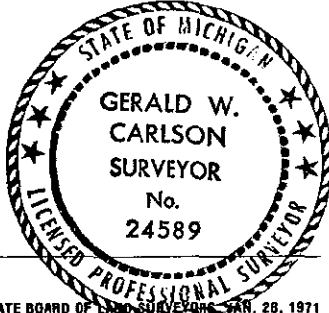

Signed by Gerald W. Carlson Date 12-28-94
Surveyor's Michigan License No. 24589