

APR 01 1996  
**LAND CORNER RECORDATION CERTIFICATE**  
Filing Requirement of Act 74, Mich. P.A. 1970

JOB NUMBER: 95053  
SHEET NO. : 1-621

For corners in \_\_\_\_\_ Located in: \_\_\_\_\_ Corner Code # \_\_\_\_\_  
MARQUETTE (County)

*Patricia A. Manley*  
REGISTER OF DEEDS

1. Public Land Survey	T 47N	R 26W	M-6 ✓
	T 47N	R 25W	A-6
	T _____	R _____	_____
	T _____	R _____	_____
2. Property Controlling in Section	S _____	T _____	R _____
	S _____	T _____	R _____
3. Miscellaneous Property in Section	S _____	T _____	R _____
	S _____	T _____	R _____

LIBER 1 PAGE 23  
Register of Deeds Stamp & File Number

4. Lot No. \_\_\_\_\_, Recorded Plat \_\_\_\_\_  
5. Private Claims \_\_\_\_\_

A	B	C	D	E	F	G	H	I	J	K	L
2	6	5	4	3	2	1					
3											
4	7	8	9	10	11	12					
5											
6	18	17	16	15	14	13					
7											
8	19	20	21	22	23	24					
9											
10	30	29	28	27	26	25					
11											
12	31	32	33	34	35	36					
13											

GERALD W. CARLSON, in a field survey on Thursday, November 9, 1995, do hereby certify that under requirements of P.A. 74, Michigan P.A. of 1970, the corner points mentioned in lines 1 and 2 above were in conformance with regulations and rules therefore as required in the current manual of survey instructions of the United States Department of the Interior, Bureau of Land Management or by a decree of a Court of Law and/or that the corner points mentioned in lines 3, 4 and 5 above were in conformance with the rules of the Michigan Board of Professional Surveyors or by a Decree of a Court of Law; established, re-established, monumented, re-monumented, recovered, found as expressed below:

**NOTE: Not more than 4 corners, all in the same town and range, may be recorded on this certificate.**

**A. Description of original monument and accessories and/or subsequent restoration:**

M-6: Quarter Corner common to Section 13, T47N-R26W and Section 18, T47N-R25W. 1844: William A. Burt's original survey notes describe the corner monument as a wood post referenced by:  
6" Fir S50E, 31 l.  
8" Sugar N23W, 20 l.


**B. Description of corner evidence found and/or method applied in restoring or reestablishing corner:**

1995: Found a 4" X 3' high Cedar post w/squared top lying flat on ground @ corner location. Also found a 12" Maple with old healed blazes on all four sides N72E, 3.70' from corner location. Stream line call (Rec. = 176.88' North of Corner) found at 171.2'. Corner position established by single proportion measurement on line between the N.E. and S.E. Corners of Section 13. Distances North and South are 2627.00'.

**RATIFIED BY PEER GROUP**  
**P.A. 345 OF 1990**  
*Harry J. Buosme*  
DATE 11/6/95

**C. Description of monument for corner and accessories established to perpetuate locating the position of the corner:**

1995: Set a 2 3/8" O.D. aluminum pipe capped with a 3 1/4" diameter aluminum tablet Marquette County Survey Monument stamped to identify the corner. Monument is flush with ground. Established references using double headed nails in:  
5" Hemlock N21E, 28.64'  
8" Maple S64E, 49.60'  
9" Maple S23W, 10.20'  
6" Maple N49W, 16.44'  
Green Steel Sign Post w/Yellow Survey Marker Sign North, 1.0'  
Bk. 9, pp. 61-62.

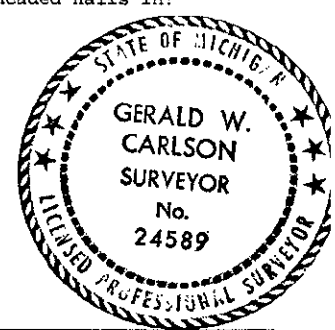

Signed by *Gerald W. Carlson*

Date 12-15-95

Surveyor's Michigan License No. 24589