

1993

COMMISSION

JOB NUMBER: 93300
SHEET NO. : 1-404
For corners in

LAND CORNER RECORDATION CERTIFICATE
Filing Requirement of Act 74, Mich. P.A. 1970

MARQUETTE COUNTY
MICHIGAN
RECEIVED FOR RECORD
1993 DEC 29 AM 10:43
REGISTER OF DEEDS

	Located In:	Corner Code #
1. Public Land Survey	T 47N R 27W	A-9
	T 47N R 28W	M-9
	T R	
	T R	
2. Property Controlling in Section	S T R	
	S T R	
3. Miscellaneous Property in Sec.	S T R	
	S T R	

LIBER 1 PAGE 74
Register of Deeds Stamp & File Number

4. Lot No. _____, Recorded Plat _____
5. Private Claims _____

I, GERALD W. CARLSON, in a field survey on Tuesday, December 21, 1993, do hereby certify that under requirements of P.A. 74, Michigan P.A. of 1970, the corner points mentioned in lines 1 and 2 above were in conformance with regulations and rules therefore as required in the current manual of survey instructions of the United States Department of the Interior, Bureau of Land Management or by a decree of a Court of Law and/or that the corner points mentioned in lines 3, 4 and 5 above were in conformance with the rules of the Michigan Board of Land Surveyors or by a Decree of a Court of Law; established, re-established, monumented, re-monumented, recovered, found as expressed below:

	A	B	C	D	E	F	G	H	I	J	K	L	M
2	6	5	4	3	2	1							
3													
4	7	8	9	10	11	12							
5													
6	18	17	16	15	14	13							
7													
8	19	20	21	22	23	24							
9													
10	30	29	28	27	26	25							
11													
12	31	32	33	34	35	36							
13													

NOTE: Not more than 4 corners, all in the same town and range, may be recorded on this certificate.

A. Description of original monument and accessories and/or subsequent restoration:

A-9: Section Corner common to Sections 19 and 30, T47N-R27W and Sections 24 and 25, T47N-R28W. 1846: Austin Burt's original survey notes describe the corner monument as Sugar post referenced by:

- 8" Ironwood N36E, 8 l
- 14" W.Pine S71W, 23 l

C.C.I. aerial photo coordinates 1" iron S20663.24, W36875.58 (S20662.36, W36876.10)

No date given - Marquette County Road Commission field book indicates 2" iron pipe 5.0' above ground? 1980 - G. Carlson found a bent iron on the South edge of East/West gravel road that he replaced with a 5/8 x 18" iron with RLS cap at base of bent iron. Fence to South. Referenced by:

- 6" White Birch S62W 26.50 ft. 18" Maple N09E 43.79 ft.
- 15" Maple S08E 11.45 ft.
- 12" Maple N48E 56.79 ft. L4 RC, Pg. 27

B. Description of corner evidence found and/or method applied in restoring or reestablishing corner:


1993 - Found 5/8 iron with cap GcVN 27464 at the NW cor. sec. 30 that checked with the Carlson NBT's from 1980. Set a Marquette County Survey Monument on rebar. Peer group ratification 12-20-93.

C. Description of monument for corner and accessories established to perpetuate locating the position of the corner:

1993 - Set a 3 1/4" diameter aluminum tablet Marquette County Survey Monument on existing 5/8" rebar stamped to identify the corner referenced by nails in:

- 19" Maple S03E 11.37 ft. Carlson NBT
- 8" White Birch S64W 26.49 ft. Carlson NBT
- 4" Maple N06W 44.95 ft.
- 15" Maple N54E 56.83 ft. Carlson NBT

Monument is 0.4 ft. deep of the South edge of the gravel road at fence line to the South.
Bk. 5, Pg. 10

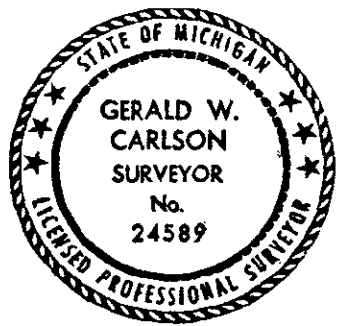

Signed by Gerald W. Carlson Date 12-28-93

Surveyor's Michigan License No. 24589