

JOB NUMBER: 93300
SHEET NO. : 1-405

LAND CORNER RECORDATION CERTIFICATE
Filing Requirement of Act 74, Mich. P.A. 1970

For corners in
MARQUETTE
(County)

Located In: Corner Code #

1. Public Land Survey	T 47N 27W	A-10 ✓
	T 47N R 28W	M-10
	T R	
	T R	
	T R	
2. Property Controlling In Section	S T R	
	S T R	
3. Miscellaneous Property in Sec.	S T R	
	S T R	

1993
COMMISSION

MARQUETTE COUNTY
MICHIGAN
RECEIVED FOR RECORD

1993 DEC 29 AM 10:43

REGISTER OF DEEDS

LIBER 1 PAGE 70
Register of Deeds Stamp & File Number

4. Lot No. _____, Recorded Plat _____
5. Private Claims _____

	A	B	C	D	E	F	G	H	I	J	K	L	M
2	6	5	4	3	2								
3													
4	7	8	9	10	11	12							
5													
6	18	17	16	15	14	13							
7													
8	19	20	21	22	23	24							
9													
10	30	29	28	27	26	25							
11													
12	31	32	33	34	35	36							
13													

I, GERALD W. CARLSON, in a field survey on Tuesday, December 21, 1993


do hereby certify that under requirements of P.A. 74, Michigan P.A. of 1970, the corner points mentioned in lines 1 and 2 above were in conformance with regulations and rules therefore as required in the current manual of survey instructions of the United States Department of the Interior, Bureau of Land Management or by a decree of a Court of Law and/or that the corner points mentioned in lines 3, 4 and 5 above were in conformance with the rules of the Michigan Board of Land Surveyors or by a Decree of a Court of Law; established, re-established, monumented, re-monumented, recovered, found as expressed below:

NOTE: Not more than 4 corners, all in the same town and range, may be recorded on this certificate.

A. Description of original monument and accessories and/or subsequent restoration:
A-10: Quarter Corner common to Section 30, T47N-R27W and Section 25, T47N-R28W. 1846: Austin Burt's original survey book indicates a squared stake below pavement. No corner notes describe the corner monument as a Cedar post referenced by:
8" Y.Birch S77W, 19 1
14" Cedar N78E, 14 1
No date given - Marquette County Road Commission field accessories given.
1965 - R.D. Washburn found a magnetic dip at this point and set railroad spike in pavement over dip. No corner accessories given.
C.C.I. Co. aerial photo coordinates P-K in road
S23306.01, W36889.80 (S23301.75, W36892.65)
(See reverse side).

B. Description of corner evidence found and/or method applied in restoring or reestablishing corner:
1993 - Found GcVN P-k and tab in centerline +/- County Road 581 and centerline +/- County Road PN that checks with G. Carlson and W. Robey witnesses.
Peer group ratification 12-20-93.

C. Description of monument for corner and accessories established to perpetuate locating the position of the corner:
1993 - Replaced P-k and tab with a 3 1/4" diameter aluminum tablet Marquette County Survey Monument on a 3/4" x 18" rebar in a monument box in the centerline of County Road 581 stamped to identify the corner referenced by nails in:
15" Spruce S67E 84.83 ft. Carlson NBT
Guy Pole N53W 36.76 ft. Robey NBT
6" Balsam N53E 66.21 ft.
6" Cedar N40E 70.63 ft.
Power Pole N50E 38.85 ft. Bk. 5, Pg. 8

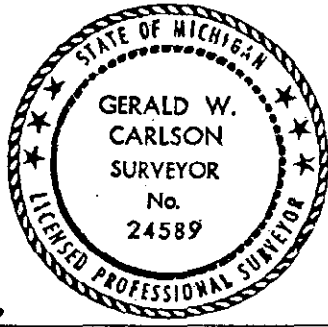

Signed by Gerald W. Carlson Date 12-28-93
24589

Record No. 405

Part "A" Continued:

1978 - Joe Wasie found a railroad spike in centerline of road referenced by:

16" Spruce	S70E	84.95 ft.
Power Pole	N44E	41.55 ft.
Tele. Pole	S20E	78.48 ft.

L1 RC, Pg. 258

1980 - G. Carlson found a railroad spike in road intersection on the centerline of County Road "PN" .5 ft. East of centerline of County Road 581.

Referenced by:

Power pole	N46°E	41.60 ft.
18" Spruce	S70°E	84.90 ft.
Tele. pole	S26°E	78.44 ft.

L4 RC, Pg. 27

1991 - Marquette County Road Commission field notes by WFR.

16" Spruce	S70°E	84.95 ft.
Utility pole	N44°E	41.55 ft.
Tele. Pole	S20°E	78.48 ft.

Pole cut off, PK under metal cover on East side 1 1/2' above ground.

Anchor pole	N56°W	36.75 ft. Mas. nail.
-------------	-------	----------------------

Handwritten:
11/11/11
#900
#900