

JOB NUMBER: 95053 APR 01 1996  
 SHEET NO. : 1-633

LAND CORNER RECORDATION CERTIFICATE  
 Filing Requirement of Act 74, Mich. P.A. 1970


For corners in **COMMISSION**

Located In:	Corner Code #
MARQUETTE (County)	C-2
1. Public Land Survey	T <sup>47N</sup> R <sup>27W</sup>
	T R
	T R
	T R
	T R
2. Property Controlling in Section	S T R
	S T R
3. Miscellaneous Property in Section	S T R
	S T R

REGISTER OF DEEDS  
 MARQUETTE COUNTY  
 MICHIGAN  
 RECEIVED FOR RECORD  
 1995 DEC 27 AM 7:45  
*Robert A. Henderson*

LIBER 1 PAGE 24  
 Register of Deeds Stamp & File Number

4. Lot No. \_\_\_\_\_, Recorded Plat \_\_\_\_\_  
 5. Private Claims \_\_\_\_\_

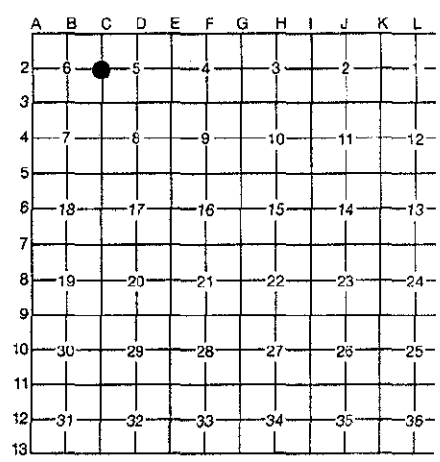

I, GERALD W. CARLSON, in a field survey on Tuesday, November 28, 1995, do hereby certify that under requirements of P.A. 74, Michigan P.A. of 1970, the corner points mentioned in lines 1 and 2 above were in conformance with regulations and rules therefore as required in the current manual of survey instructions of the United States Department of the Interior, Bureau of Land Management or by a decree of a Court of Law and/or that the corner points mentioned in lines 3, 4 and 5 above were in conformance with the rules of the Michigan Board of Professional Surveyors or by a Decree of a Court of Law; established, re-established, monumented, re-monumented, recovered, found as expressed below:

**NOTE: Not more than 4 corners, all in the same town and range, may be recorded on this certificate.**

**A. Description of original monument and accessories and/or subsequent restoration:**

C-2: Quarter Corner common to Sections 5 and 6. 1848: John Burt's original survey notes describe the corner monument as a wood post referenced by:  
 12" W. Pine Due West, 45.9'  
 8" W. Birch N02E, 53.5'  
 4" Spruce S02W, 18.0'  
 18" Lynn S07E, 20 l  
 18" Sugar N55W, 26 l  
 1992: An LCRC recorded by Larry J. Bussone RLS #25833 in L. 5, RC Pg. 353, indicates the corner as a found iron rail.  
 No Date: The corner is shown on an unidentified map recorded in L. 109, MR Pg. 168. Corner was monumented by Cleveland-Cliffs in the early 1900's. Checks with old Co:ord data on corner. References:  
 1977: A Certificate of Survey recorded by Joseph O. Wasie RLS #15415 in L. 325, Deeds Pg. 500, indicates the corner as a found iron rail referenced by:  
 6" Poplar S65W, 5.1' 6" Spruce S02W, 18.0'  
 8" W. Birch N02E, 53.5' 10" W. Birch S02E, 49.5'

**B. Description of corner evidence found and/or method applied in restoring or reestablishing corner:**

1995: Found and accepted a railroad rail with punch mark in small pile of rocks, 0.90' above ground. Distance North is 2571.58' and Distance South is 2630.65'.


RATIFIED BY PEER GROUP  
 P.A. 345 OF 1990  
*Larry J. Bussone*  
 DATE 11/13/95

**C. Description of monument for corner and accessories established to perpetuate locating the position of the corner:**

1995: Ishpeming Township welders welded a 3/4" X 7" rebar on top of found rail, and we capped it with a 3 1/4" aluminum tablet Marquette County Survey Monument, 0.62' above the rail and 1.5' above the ground, and stamped to identify the corner. Punched a "+" mark in the correct corner position on the aluminum tablet, and blotted out the ready made punch mark found at the center of the tablet. Established references using set duplex nails in:

16" W. Pine	S76W,	96.84'
14" Spruce	N02E,	111.57'
7" W. Pine	N51E,	47.33'
7" W. Birch	S62E,	72.55'
Green Steel Sign Post w/Survey Marker Sign	N04W,	2.5'

Bk. 11, PP. 87-88.

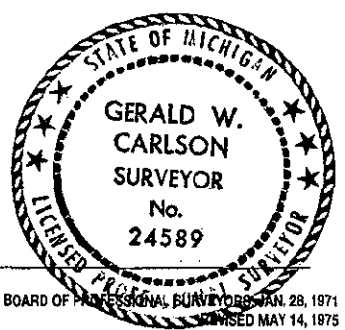

Signed by Gerald W. Carlson

Date 12-20-95

Surveyor's Michigan License No. 24589