

**SURVEY & REMONUMENTATION**

MARQUETTE COUNTY MICHIGAN RECEIVED FOR RECORD

JOB NUMBER: 94030

**LAND CORNER RECORDATION CERTIFICATE**

SHEET NO. : 1-494

APR 28 1995

Filing Requirement of Act 74, Mich. P.A. 1970

1994 DEC 28 PM 5:57

For corners in

MARQUETTE (County)

**COMMISSION**

Plotted In: Corner Code #

*Patricia A. Moulton*  
REGISTER OF DEEDS

- 1. Public Land Survey T 47N R 27W H-13: \_\_\_\_\_  
T \_\_\_\_\_ R \_\_\_\_\_  
T \_\_\_\_\_ R \_\_\_\_\_  
T \_\_\_\_\_ R \_\_\_\_\_
- 2. Property Controlling S \_\_\_\_\_ T \_\_\_\_\_ R \_\_\_\_\_  
in Section S \_\_\_\_\_ T \_\_\_\_\_ R \_\_\_\_\_
- 3. Miscellaneous S \_\_\_\_\_ T \_\_\_\_\_ R \_\_\_\_\_  
Property in Sec. S \_\_\_\_\_ T \_\_\_\_\_ R \_\_\_\_\_

Register of Deeds Stamp & File Number **1** PAGE **164**

- 4. Lot No. \_\_\_\_\_, Recorded Plat \_\_\_\_\_
- 5. Private Claims \_\_\_\_\_

	A	B	C	D	E	F	G	H	I	J	K	L	M
2	6	5	4	3	2								
3													
4	7	8	9	10	11	12							
5													
6	18	17	16	15	14	13							
7													
8	19	20	21	22	23	24							
9													
10	30	29	28	27	26	25							
11													
12	31	32	33	34	35	36							
13													

GERALD W. CARLSON, in a field survey on Monday, December 19, 1994, do hereby certify that under requirements of P.A. 74, Michigan P.A. of 1970, the corner points mentioned in lines 1 and 2 above were in conformance with regulations and rules therefore as required in the current manual of survey instructions of the United States Department of the Interior, Bureau of Land Management or by a decree of a Court of Law and/or that the corner points mentioned in lines 3, 4 and 5 above were in conformance with the rules of the Michigan Board of Land Surveyors or by a Decree of a Court of Law; established, re-established, monumented, re-monumented, recovered, found as expressed below:

**NOTE: Not more than 4 corners, all in the same town and range, may be recorded on this certificate.**

**Description of original monument and accessories and/or subsequent restoration:**

H-13: 1/4 Corner common to Section 3, T46N-R27W and Section 34, T47N-R27W.  
1846: Austin Burt's original survey notes describe the corner monument as a Maple post referenced by:  
8" Fir N33 1/2E 18 1  
8" Sugar N39W 10 1  
1921: Old field notes of Section 34, T47N-R27W from CCI Company indicates a South 1/4 corner of Section 34 as a square Pine. No corner accessories given.

1933: MCRC field book No. 587 indicates a North 1/4 corner of Section 3, T46N-R27W as a squared White Pine. Found no evidence of original B.T.'s. Sugar and Fir B.T.'s have disappeared. However, the US field notes locate the squared White Pine very closely if not exactly to the original location. On West side of granite ledge showing slight indications of iron ore. (See reverse side).

**Description of corner evidence found and/or method applied in restoring or reestablishing corner:**

1994: Found and accepted 1/2" rerod as referenced in Part "A" above. Distance West is 2616.65' and distance East is 2613.76'.

**RATIFIED BY PEER GROUP  
P.A. 345 OF 1990**

*Larry J. Bussard*  
DATE Dec 6, 1994


**Description of monument for corner and accessories established to perpetuate locating the position of the corner:**

1994 - Replaced 1/2" iron and cap #25839/30091 with a 2 1/2" diameter aluminum pipe capped with a 3 1/4" diameter aluminum tablet Marquette County Survey Monument stamped to identify the corner referenced by nails in:  
12" White Pine S30E 17.53 ft. Clark NBT  
12" White Pine S03W 6.18 ft. Clark NBT  
12" White Pine S29W 19.12 ft. Clark NBT  
17" Twin Oak N55W 18.72 ft. Clark NBT  
Steel sign post East 1.0 ft.  
Monument is 0.40' above ground.  
Bk. 8, Pg. 51

igned by Gerald W. Carlson

Date 12-22-94

urveyor's Michigan License No. 24589

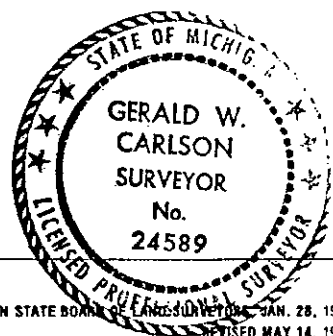

Record No. 494

*R.H. G.  
Geo  
Leo  
Ken*

1986: A Certificate of Survey filed by James Minard RLS No. 30091 recorded in L, 358 pg. 631 indicates a North 1/4 corner of Section 3 T46N-R27W as a set capped re-bar. No corner accessories given.

1986: Land Corner Recordation Certificate filed by Charles F. Clark RLS No. 25836 found no evidence of prior corner monumentation - established on straight line between G-1 and I-1 2616.62' East of G-1 and 2613.67' West of I-1. Referenced by PK nails in:

24" Twin Oak	N45W	18.65
15" White Pine	S10W	6.21
14" White Pine	S19E	17.63
15" White Pine	S39W	19.13

Liber, 5RC, pg. 88