

LAND CORNER RECORDATION CERTIFICATE

APR 01 1995 Filing Requirement of Act 74, Mich. P.A. 1970


For corners in

For corners in	Located In:	Corner Code #
MARQUETTE (County)	COMMISSION	
1. Public Land Survey	T <u>47N</u> R <u>27W</u>	I-3
	T _____ R _____	_____
	T _____ R _____	_____
	T _____ R _____	_____
2. Property Controlling in Section	S _____ T _____ R _____	_____
	S _____ T _____ R _____	_____
3. Miscellaneous Property in Section	S _____ T _____ R _____	_____
	S _____ T _____ R _____	_____

RECEIVED FOR RECORD
 MARQUETTE COUNTY
 MICHIGAN
 1995 DEC 27 AM 7:46
 REGISTER OF DEEDS
John A. Hurd

LIBER 1 PAGE 260
Register of Deeds Stamp & File Number

4. Lot No. _____, Recorded Plat _____
5. Private Claims _____

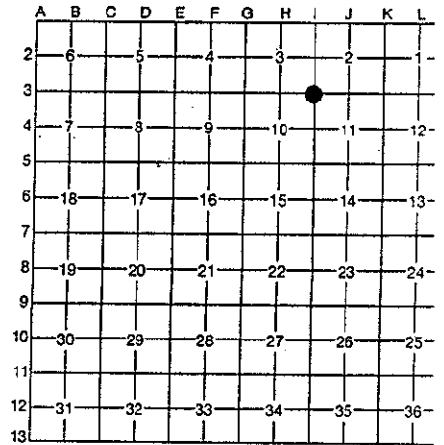

I, GERALD W. CARLSON, in a field survey on Monday, December 11, 1995, do hereby certify that under requirements of P.A. 74, Michigan P.A. of 1970, the corner points mentioned in lines 1 and 2 above were in conformance with regulations and rules therefore as required in the current manual of survey instructions of the United States Department of the Interior, Bureau of Land Management or by a decree of a Court of Law and/or that the corner points mentioned in lines 3, 4 and 5 above were in conformance with the rules of the Michigan Board of Professional Surveyors or by a Decree of a Court of Law; established, re-established, monumented, re-monumented, recovered, found as expressed below:

NOTE: Not more than 4 corners, all in the same town and range, may be recorded on this certificate.

A. Description of original monument and accessories and/or subsequent restoration:

I-3: Section Corner common to Sections 2, 3, 10, and 11. 1848: John Burt's original survey notes describe the corner monument as a Sugar post referenced by:
 10" Fir S67W, 20 l
 18" Elm N49E, 20 l
 1891: G.P. and Charles Cummings, in Record of Surveys Pg. 205, indicate the corner as an iron monument. Distance North to West 1/4 Corner of Section 2 is 2633.20', and Distance East to South 1/4 Corner of Section 2 is 2609.00'.
 1891: Charles Cummings, in Record of Surveys Pg. 225, indicates the corner as being 2573.00' North of the East 1/4 Corner and 5146.00' North of the SE Corner of Section 10.
 1892: George Cummings, in Record of Surveys Pg. 209, indicates the corner as being 2645.4' South of the East 1/4 Corner of Section 3. No accessories given.
 No Date: The corner is shown on an unidentified map recorded in L. 331, Deeds Pg. 449.
 No Date: The corner is shown on an unidentified map recorded in L. 284, Deeds Pg. 389.
 No Date: The corner is indicated (See Reverse Side)

B. Description of corner evidence found and/or method applied in restoring or reestablishing corner:

1995: Searched, and no subsequent evidence or corner found. Distance East is 2610.86', Distance West is 2647.08', and Distance North is 2634.23'. Line call (Rec. = Ascend Hill 2.00 Ch. [132.0'] North of corner) found @ 105'. This corner was re-set at the intersection of the lines extended from the found Cummings mushroom monuments at the East 1/4 Corner of Section 2 and the South 1/16 Corner to Sections 2 and 3 and the found iron at the South 1/4 Corner of Section 3 and the found Cummings mushroom at the East 1/16 Corner to Sections 3 and 10. The position checks reasonably well with the found concrete monuments in the Assessor's Plats of Spring Street and New York Location.

**RATIFIED BY PEER GROUP
P.A. 345 OF 1990**
Lang J. Bussone
 DATE 11/13/95

C. Description of monument for corner and accessories established to perpetuate locating the position of the corner:

1995: Set a 3/4" X 24" rebar capped with a 3 1/4" aluminum tablet Marquette County Survey Monument drilled and grouted in rock flush with ground, and stamped to identify the corner. Established references using duplex nails set in:
 6" W. Birch N70W, 28.78'
 4" W. Birch N51E, 27.13'
 3" J. Pine N78E, 30.15'
 5" W. Birch S69E, 16.15'
 Survey Marker Sign Nailed To 7" Aspen N82E, 16.0'

Note: Bearing trees were face and butt blazed, painted, and had B.T. Tags affixed. Corner is 3.0' North from steep drop into mine pit.
 Bk. 9, PP. 89-92.

Signed by Gerald W. Carlson
 Surveyor's Michigan License No. 24589

Date 12-20-95



Record No. 637:

Part A Continued:

on an unidentified map recorded in L. 283, Deeds Pg. 561.

No Date: The corner is shown on an unidentified map recorded in L. 283, Deeds Pg. 573.

1978: An LCRC recorded by Charles F. Clark, in L. 1, RC Pg. 299, indicates the corner as a found 1" iron with hexagonal head used in prior surveys and in CCIC land corner records; best evidence of true corner location. Set witnesses consisting of PK Nails in:

4" W. Birch	N52W,	19.86'
4" W. Birch	N08W,	11.04'
4" Poplar	S33E,	9.73'

1979: The corner is indicated as a found 1" Iron Rod on the Assessor's Plat of Spring Street surveyed by Charles F. Clark RLS #25836, recorded in L. 4, Plats Pg. 17.

No Date: The corner is indicated as a found 1" Iron Pin on the Assessor's Plat Of The New York Location, surveyed by Charles F. Clark RLS #25836. No Liber or Page given.

1986: The corner is indicated as a 1" Iron Rod on a Certificate of Survey recorded by Charles F. Clark RLS #25836 in L. 359, Deeds Pg. 349. Distance N89-38-30W, 2647.26' to the 1/4 Corner common to Sections 3 and 10. No accessories given.

Handwritten: R# 9000 5000 6000