

**SURVEY &
REMONUMENTATION**

JOB NUMBER: 94030

SHEET NO. : 1-496

LAND CORNER RECORDATION CERTIFICATE

Filing Requirement of Act 74, Mich. P.A. 1970

MARQUETTE COUNTY
MICHIGAN
RECEIVED FOR RECORD

1994 DEC 28 PM 5:57

For corners in

APR 28 1995

MARQUETTE
(County)

COMMISSION

Corner Code #

- | | | | | | |
|---------------------------------------|---|-----|---|-----|------|
| 1. Public Land Survey | T | 47N | R | 27W | J-13 |
| | T | | R | | |
| | T | | R | | |
| | T | | R | | |
| 2. Property Controlling
in Section | S | | T | R | |
| | S | | T | R | |
| 3. Miscellaneous
Property in Sec. | S | | T | R | |
| | S | | T | R | |
4. Lot No. _____, Recorded Plat _____
5. Private Claims _____

Patricia H. Moberg
REGISTER OF DEEDS

LIBER 1 PAGE 165
Register of Deeds Stamp & File Number

I, GERALD W. CARLSON, in a field survey on Tuesday, December 20, 1994, do hereby certify that under requirements of P.A. 74, Michigan P.A. of 1970, the corner points mentioned in lines 1 and 2 above were in conformance with regulations and rules therefore as required in the current manual of survey instructions of the United States Department of the Interior, Bureau of Land Management or by a decree of a Court of Law and/or that the corner points mentioned in lines 3, 4 and 5 above were in conformance with the rules of the Michigan Board of Land Surveyors or by a Decree of a Court of Law; established, re-established, monumented, re-monumented, recovered, found as expressed below:

NOTE: Not more than 4 corners, all in the same town and range, may be recorded on this certificate.

	A	B	C	D	E	F	G	H	I	J	K	L	M
2	6		5		4		3		2		1		
3													
4	7		8		9		10		11		12		
5													
6	18		17		16		15		14		13		
7													
8	19		20		21		22		23		24		
9													
10	30		29		28		27		26		25		
11													
12	31		32		33		34		35		36		
13													

A. Description of original monument and accessories and/or subsequent restoration:

J-13: 1/4 Corner common to Section 2, T46N-R27W and Section 35, T47N-R27W.
1846: Austin Burt's original survey notes describe the corner monument as a Sugar post referenced by:
7" Sugar N59E 44 l
36" White Pine N21W 38 l

B. Description of corner evidence found and/or method applied in restoring or reestablishing corner:


1994: Corner position established equidistant and on line between the Southwest and Southeast Corners of Section 35. Distances West and East are 2665.16'.

**RATIFIED BY PEER GROUP
P.A. 345 OF 1990**

Larry J. Bussone
DATE Dec 6, 1994

C. Description of monument for corner and accessories established to perpetuate locating the position of the corner:

1994 - Set a 2 1/2' long 3/4" iron capped with a 3 1/4" diameter aluminum tablet Marquette County Survey Monument stamped to identify the corner referenced by nails in:
5" Ironwood N19E 15.92 ft.
7" Maple S42E 17.82 ft.
8" Maple S15W 40.60 ft.
7" Maple N78W 25.08 ft.
Steel sign post South 1.0 ft.
Monument is set flush with ground, concreted into a rock that is 0.50' below ground.
Ek. 8, Pg. 55

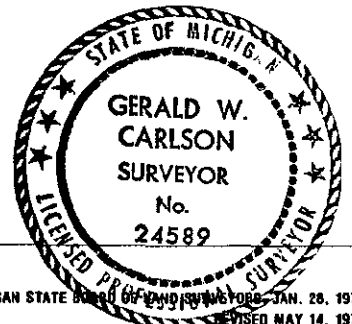

Signed by Gerald W. Carlson Date 12-22-94
Surveyor's Michigan License No. 24589