

SECTION

MARQUETTE COUNTY MICHIGAN RECEIVED FOR RECORD

1998 DEC 29 PM 3:19

LAND CORNER RECORDATION CERTIFICATE Filing Requirement of Act 74, Mich. P.A. 1970

For corners in MARQUETTE (County) Located In: Corner Code # 1. Public Land Survey T 47N R 28W J-5 2. Property Controlling in Section S T R 3. Miscellaneous Property in Sec. S T R

Patricia L. Monroy REGISTER OF DEEDS

LIBER R 2 PAGE 91

Register of Deeds Stamp & File Number

4. Lot No. , Recorded Plat 5. Private Claims

I, GERALD W. CARLSON, in a field survey on 19 98, do hereby state that under requirements of P.A. 74, Michigan P.A. of 1970, the corner points mentioned in lines 1 and 2 above were in conformance with regulations and rules therefore as required in the current manual of survey instructions of the United States Department of the Interior, Bureau of Land Management or by a decree of a Court of Law and/or that the corner points mentioned in lines 3, 4 and 5 above were in conformance with the rules of the Michigan Board of Land Surveyors or by a Decree of a Court of Law; established, re-established, monumented, recovered, found as expressed below:

Grid table with columns A-L and rows 1-13. A dot is marked at the intersection of column J and row 5.

NOTE: Not more than 2 corners, all in the same town and range, may be recorded on this certificate.

A. Description of original monument and accessories and/or subsequent restoration: J-5: Quarter Corner common to Sections 11 and 14.

1848: John Burt's original subdivision survey notes describe the corner monument as a Maple post referenced by: 10" Spruce S75E, 14 L 18" W. Pine N52W, 27 L

B. Description of corner evidence found and/or method applied in restoring or reestablishing corner:

J-5: 1998: No original corner evidence found. The corner was set equidistant between the Southwest and Southeast corners of Section 11 on an old ancient barbed wire fence line located South of the Wawonowin Golf Club golf cart barn. A rock fence was located North of the ancient barb wire fence. Old aerial photographs, circa 1930's, indicates a field North of the Section line in this area which would explain the rock fence lying North of the wood post barb wire fence. The ancient fence is approximately 10' South of the straight line between the Section Corners making a slight bend in the Section line at the 1/4 corner. Distance East and West is 2634.61'.

C. Description of monument for corner and accessories established to perpetuate locating the position of the corner:

J-5: 1998: Set a 2 3/8" O.D. aluminum pipe capped with a 3 1/4" diameter aluminum tablet Marquette County Survey Monument stamped to identify the corner. Monument falls on Southerly edge of Rock "Fence" and on an ancient East-West barbed-wire fence. Monument is 1.0' above ground. Referenced by:

8" Balsam N69W, 21.05' (to set d.h. nail) 5" Balsam S77W, 24.43' (to set d.h. nail) 7" Balsam S59E, 10.40' (to set d.h. nail) 11" Spruce N59E, 10.21' (to set d.h. nail)


N.W. Tree of 10" Triple Maple Cluster w/ Yellow Survey Marker Sign, S12W, 1.68' to face. (Note: Too rocky to set post.)

Note: Bearing trees have painted face, butt, and side nail blazes, d.h. measuring nails, and stamped B.T. Tags affixed.

Bk. 14, Pg. 114

RATIFIED BY PEER GROUP P.A. 345 OF 1990

Larry J. Brunsell DATE 11/30/98

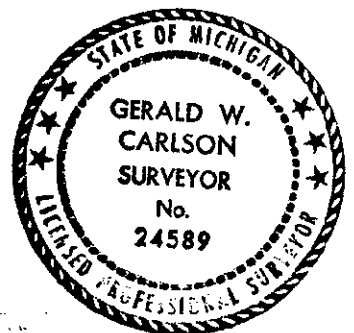

Signed by Gerald W. Carlson

Date 12-28-98

Surveyor's Michigan License No. 24589