

JOB NUMBER: 93300  
SHEET NO. : 1-400  
For corners in

**LAND CORNER RECORDATION CERTIFICATE**  
**Filing Requirement of Act 74, Mich. P.A. 1970**

MARQUETTE COUNTY  
 RECEIVED FOR RECORDATION  
 2003 DEC 29 AM 10:44  
 1 PAGE 78  
 Register of Deeds Stamp & File Number

<u>MARQUETTE</u> (County)	Located In:	Corner Code #	
1. Public Land Survey	T <u>47N</u> R <u>27W</u>	A-5	
	T <u>47N</u> R <u>28W</u>	M-5	
	T _____ R _____		
	T _____ R _____		
2. Property Controlling in Section	S _____ T _____ R _____		
	S _____ T _____ R _____		
3. Miscellaneous Property in Sec.	S _____ T _____ R _____		
	S _____ T _____ R _____		
4. Lot No. _____, Recorded Plat _____			
5. Private Claims _____			

I, GERALD W. CARLSON, in a field survey on Wednesday, December 22, 1993, do hereby certify that under requirements of P.A. 74, Michigan P.A. of 1970, the corner points mentioned in lines 1 and 2 above were in conformance with regulations and rules therefore as required in the current manual of survey instructions of the United States Department of the Interior, Bureau of Land Management or by a decree of a Court of Law and/or that the corner points mentioned in lines 3, 4 and 5 above were in conformance with the rules of the Michigan Board of Land Surveyors or by a Decree of a Court of Law; established, re-established, monumented, re-monumented, recovered, found as expressed below:

A	B	C	D	E	F	G	H	I	J	K	L	M
2	6	5	4	3	2	1						
3												
4	7	8	9	10	11	12						
5												
6	18	17	16	15	14	13						
7												
8	19	20	21	22	23	24						
9												
10	30	29	28	27	26	25						
11												
12	31	32	33	34	35	36						
13												

**NOTE: Not more than 4 corners, all in the same town and range, may be recorded on this certificate.**

**A. Description of original monument and accessories and/or subsequent restoration:**

A-5: Section Corner common to Sections 7 and 18, T47N-R27W 1940 - Cleveland Cliffs Iron Company North Lake coordinates and Sections 12 and 13, T47N-R28W, 1946: Austin Burt's original survey notes describe the corner monument as a Sugar post referenced by:  
 16" Sugar S28W, 31 l.  
 8" Hemlock N68E, 12 l.


1940 - Cleveland Cliffs Iron Company North Lake coordinates indicate the coordinates for the corner as S10379.19 E14.10 no description of the corner monument or corner accessories were given.  
 C.C.I. aerial coordinates, iron mushroom S10123.52, W36804.53  
 1978 - Joe Wasie found a 12" cast iron mushroom referenced by:  
 24" Maple S75W 19.56 ft., 20" Oak N30W 32.25 ft.  
 7" Maple S60E 21.62 ft. L1 RC, Pg. 254

**B. Description of corner evidence found and/or method applied in restoring or reestablishing corner:**

1993 - Found 12" diameter Cummings mushroom stamped as follows; Set by C.P. Cummings, Feb. 1897, Cleveland Cliffs, SW Cor. Sec. 7, T46N-R27W. Left iron mushroom as found. Peer group ratification 12-20-93.

**C. Description of monument for corner and accessories established to perpetuate locating the position of the corner:**

1993 - Found a 12" diameter cast iron mushroom set by C.P. Cummings in Feb. 1897 with raised letters to identify the corner referenced by nails in:  
 4" Maple S80W 19.56 ft. Wasie NBT  
 18" Oak N19W 32.29 ft.  
 10" Maple N45E 43.76 ft.  
 9" Maple S47E 21.68 ft. Wasie NBT  
 Monument is 1.0 ft. above ground.  
 Bk. 5, Pg. 14

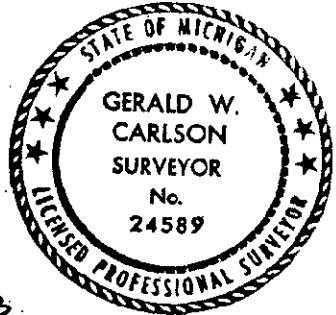

Signed by Gerald W. Carlson  
 Surveyor's Michigan License No. 24589

Date 12-28-93