

1993

COMMISSION

LAND CORNER RECORDATION CERTIFICATE
Filing Requirement of Act 74, Mich. P.A. 1970

JOB NUMBER: 93300
SHEET NO. : 1-406
For corners in

<u>MARQUETTE</u> (County)	Located In:	Corner Code #
1. Public Land Survey	T <u>47N</u> R <u>27W</u>	<u>A-11</u>
	T <u>47N</u> R <u>28W</u>	<u>M-11</u> ✓
	T _____ R _____	_____
	T _____ R _____	_____
2. Property Controlling in Section	S _____ T _____ R _____	_____
	S _____ T _____ R _____	_____
3. Miscellaneous Property in Sec.	S _____ T _____ R _____	_____
	S _____ T _____ R _____	_____

LIBER 1 PAGE 73
Register of Deeds Stamp & File Number

RECEIVED FOR RECORDING
MARQUETTE COUNTY MICHIGAN
1993 DEC 29 AM 10:43

4. Lot No. _____, Recorded Plat _____
5. Private Claims _____

A	B	C	D	E	F	G	H	I	J	K	L	M
2	6	5	4	3	2	1						
3												
4	7	8	9	10	11	12						
5												
6	18	17	16	15	14	13						
7												
8	19	20	21	22	23	24						
9												
10	30	29	28	27	26	25						
11												
12	31	32	33	34	35	36						
13												

I, GERALD W. CARLSON, in a field survey on Tuesday, December 21, 1993, do hereby certify that under requirements of P.A. 74, Michigan P.A. of 1970, the corner points mentioned in lines 1 and 2 above were in conformance with regulations and rules therefore as required in the current manual of survey instructions of the United States Department of the Interior, Bureau of Land Management or by a decree of a Court of Law and/or that the corner points mentioned in lines 3, 4 and 5 above were in conformance with the rules of the Michigan Board of Land Surveyors or by a Decree of a Court of Law; established, re-established, monumented, re-monumented, recovered, found as expressed below:

NOTE: Not more than 4 corners, all in the same town and range, may be recorded on this certificate.

A. Description of original monument and accessories and/or subsequent restoration:


A-11: Section Corner common to Sections 30 and 31, T47N-R27W No date given - Marquette County Road Commission field and Sections 25 and 36, T47N-R28W. 1846: Austin Burt's book indicates iron pin on hill referenced by: original survey notes describe the corner monument as Fir 8" White Birch N05W 16.03 ft. post referenced by: 6" Maple N33W 6.4 ft. 10" Y.Birch S27W, 36 1 This information is marked in the field book as no good 12" Y.Birch N50E, 4 1 by GWC (Carlson). He checked this out in his survey of Section 25 in 1979 found this to be incorrect.

B. Description of corner evidence found and/or method applied in restoring or reestablishing corner:

1993 - Found 5/8 bar with no cap near South edge of swamp; three of G. Carlson's witnesses checked approximately 0.09 ft. One witness measured 0.82 ft. long. Iron is upright and looks good. Replaced iron with Marquette County Survey Monument. Peer group ratification 12-20-93.

C. Description of monument for corner and accessories established to perpetuate locating the position of the corner:

1993 - Replaced existing marker with 2 1/8" diameter aluminum pipe capped with 3 1/4" diameter aluminum tablet Marquette County Survey Monument stamped to identify the corner referenced by nails in:
4" Maple S60E 8.94 ft. Carlson NBT
10" Maple S15W 18.75 ft. Carlson NBT
7" Balsam S49W 19.84 ft. Carlson NBT
8" Cedar N01W 22.41 ft. Carlson NBT
Monument is 0.10 ft. above ground in swampy area 25 ft. +/- North of toe of slope.
Bk. 5, Pg. 6

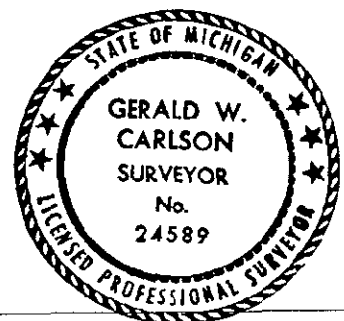

Signed by Gerald W. Carlson Date 12-28-93

Surveyor's Michigan License No. 24589