

1993

COMMISSION

JOB NUMBER: 93300

SHEET NO. : 1-350

LAND CORNER RECORDATION CERTIFICATE

Filing Requirement of Act 74, Mich. P.A. 1970

For corners in

MARQUETTE (County)

Located In:

Corner Code #

1. Public Land Survey	T 47N	R 24W	A-5
	T 47N	R 25W	M-5
	T	R	
	T	R	
2. Property Controlling in Section	S	T	R
	S	T	R
3. Miscellaneous Property in Sec.	S	T	R
	S	T	R

MARQUETTE COUNTY
 MICHIGAN
 RECEIVED FOR RECORD
 1993 DEC 29 AM 10:38
 REGISTERED DEEDS STAMP

LIBER 1 PAGE 44 Register of Deeds Stamp & File Number

4. Lot No. _____, Recorded Plat _____
 5. Private Claims _____

A	B	C	D	E	F	G	H	I	J	K	L	M
2	6	5	4	3	2	1						
3												
4	7	8	9	10	11	12						
5												
6	18	17	16	15	14	13						
7												
8	19	20	21	22	23	24						
9												
10	30	29	28	27	26	25						
11												
12	31	32	33	34	35	36						
13												

I, GERALD W. CARLSON, in a field survey on Wednesday, December 15, 1993, do hereby certify that under requirements of P.A. 74, Michigan P.A. of 1970, the corner points mentioned in lines 1 and 2 above were in conformance with regulations and rules therefore as required in the current manual of survey instructions of the United States Department of the Interior, Bureau of Land Management or by a decree of a Court of Law and/or that the corner points mentioned in lines 3, 4 and 5 above were in conformance with the rules of the Michigan Board of Land Surveyors or by a Decree of a Court of Law; established, re-established, monumented, re-monumented, recovered, found as expressed below:

NOTE: Not more than 4 corners, all in the same town and range, may be recorded on this certificate.

A. Description of original monument and accessories and/or subsequent restoration:

A-5: Section Corner common to Sections 7 and 18, T47N-R24W and Sections 12 and 13, T47N-R25W. 1844: William A. Burt's original survey notes describe the corner monument as a wood post referenced by:
 12" Y.Birch S61W, 50 1
 9" Y.Birch N75E, 18 1


1973-- corner R. Cambensy, P.S. indicates and iron bolt on the plat of Woodvale No.2.
 1977 - William Donnan, P.S. indicates a different corner on recorded plat of Highland Meadow 3.7 ft. South and 4.1 ft. West of the corner previously shown on the Plat Woodvale No. 2.
 1978 - William Donnan, P.S. shows a corner on the recorded Plat of Lee Wood. No accessories given. (See reverse side)

B. Description of corner evidence found and/or method applied in restoring or reestablishing corner:

1993 - Found a square concrete monument. Replaced concrete monument with Marquette County Survey Monument. Distances North, South and East checked from this corner position. Subsequent plats by R. Cambensy are now using the W. Donnan corner. No original G.L.O. evidence found. Peer group ratification 12-6-93.

C. Description of monument for corner and accessories established to perpetuate locating the position of the corner:

1993 - Replaced concrete monument with 2 1/8" diameter aluminum pipe capped with a 3 1/4" diameter aluminum tablet Marquette County Survey Monument stamped to identify the corner referenced by nails in:
 30" White Pine S56E 18.86 ft. Donnan NBT
 12" Maple S60W 9.98 ft. Donnan NBT
 10" White Pine N35W 25.48 ft.
 5" White Pine N43E 20.24 ft.
 Monument is 0.2 ft. above ground and falls in residential area.
 No bearing tree tags were posted.
 Ek. 4, Pg. 12

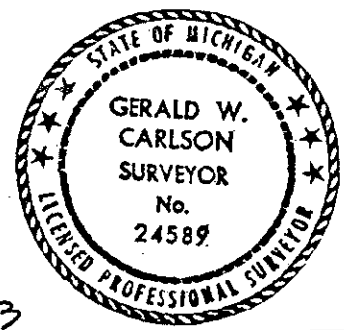

Signed by Gerald W. Carlson

Date 12-23-93

Surveyor's Michigan License No. 24589

Record No. 350

Part "A" Continued:

1979 - William Donnan, P.S. recorded a found concrete monument Referenced by :

30" Pine S50E 18.39 ft.
Triple Maple S80W 9.15 ft.
32" Pine S05W 31.20 ft.

L1 RC, Pg. 365