

1993

JOB NUMBER: 93300
SHEET NO. : 1-354
For corners in

COMMISSION
LAND CORNER RECORDATION CERTIFICATE
Filing Requirement of Act 74, Mich. P.A. 1970

MARQUETTE COUNTY
RECEIVED FOR RECORD
DEC 29 AM 10:39

Richard L. ...
1700155 of 11/28/93

	Located in:	Corner Code #
1. Public Land Survey	T 47N R 24W	A-9 ✓
	T 47N R 25W	M-9
	T _____ R _____	_____
	T _____ R _____	_____
2. Property Controlling in Section	S _____ T _____ R _____	_____
	S _____ T _____ R _____	_____
3. Miscellaneous Property in Sec.	S _____ T _____ R _____	_____
	S _____ T _____ R _____	_____

LIBER 1 PAGE 47
Register of Deeds Stamp & File Number

- 4. Lot No. _____, Recorded Plat _____
- 5. Private Claims _____

I, GERALD W. CARLSON, in a field survey on Tuesday, December 14, 1993, do hereby certify that under requirements of P.A. 74, Michigan P.A. of 1970, the corner points mentioned in lines 1 and 2 above were in conformance with regulations and rules therefore as required in the current manual of survey instructions of the United States Department of the Interior, Bureau of Land Management or by a decree of a Court of Law and/or that the corner points mentioned in lines 3, 4 and 5 above were in conformance with the rules of the Michigan Board of Land Surveyors or by a Decree of a Court of Law; established, re-established, monumented, re-monumented, recovered, found as expressed below:

NOTE: Not more than 4 corners, all in the same town and range, may be recorded on this certificate.

	A	B	C	D	E	F	G	H	I	J	K	L	M
2	6	5	4	3	2	1							
3													
4	7	8	9	10	11	12							
5													
6	18	17	16	15	14	13							
7													
8	19	20	21	22	23	24							
9													
10	30	29	28	27	26	25							
11													
12	31	32	33	34	35	36							
13													

A. Description of original monument and accessories and/or subsequent restoration:

A-9: Section Corner common to Sections 19 and 30, T47N-R24W 1976 - David Babbitt monumented a DNR 1" pipe with 4" and Sections 24 and 25, T47N-R25W. 1844: William A. Burt's aluminum cap set by single proportion to GLO record original survey notes describe the corner monument as a wood post referenced by: using Section corners 1 mile North and 1 mile South. This position fits Glo call for ridges, ravines and a stream East. Referenced by:

- 22° Hemlock S45W, 9 l
- 20° Hemlock N59E, 13 l
- 8" Yellow Birch S83W 24.4 ft.
- 4" Yellow Birch S7W 15.3 ft.
- 9" Hard Maple S89E 18.45 ft. (See reverse side)

L1 RC, Pg. 172

B. Description of corner evidence found and/or method applied in restoring or reestablishing corner:

1993 - The distance on the DNR map indicates the distance from the West 1/4 corner of the NW 1/4 corner of 19 is 2635.20 ft. The 1993 remonumentation survey measured this 1/2 mile distances 2624.08 ft. indicating a 10.12 ft. shortage from the DNR measurement in this 1/2 mile. The intent to monument this line by Dave Babbit was correct in the decision to proportion this line, and conclusive to G.L.O. calls does not substantiate movement of his corners as monumented from the SW corner of Section 30 to the NW corner of Section 19, so accept corners as found. Peer group ratification 12-6-93.

C. Description of monument for corner and accessories established to perpetuate locating the position of the corner:

1993 - Found Department of Natural Resources iron pipe and aluminum cap in place referenced by nails in:


- 9" Maple N20E 22.28 ft.
- 8" Maple S80E 18.98 ft. Babbitt NBT
- 8" Maple S31W 28.41 ft.
- 9" Yellow Birch S85W 24.65 ft. Babbitt NBT

Monument is 1.0 ft. above ground stamped MCR-1993 on cap of monument (Marquette County Remonumentation).
Bk. 2, Pg. 148

Signed by Gerald W. Carlson

Date 12-23-93

Surveyor's Michigan License No. 24589

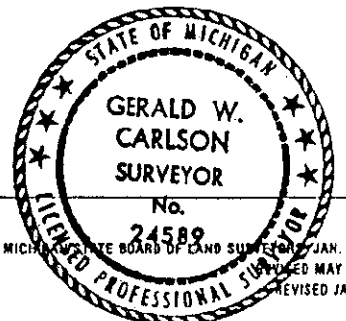

Record No. 354

Part "A" Continued:

1988 - Glenn C. Van Neste found an DNR monument referenced by:

9" Yellow Birch	Az.	266°	24.63 ft.
9" Maple	Az.	21°	22.34 ft.
9" Maple	Az.	95°	18.92 ft.
8" Maple	Az.	213°	29.32 ft.

Handwritten notes:
354
1988
Van Neste